



March 30, 2018

Re: PROJECT: Uptown240
ADDRESS: 240 Lake Dillon Drive, Dillon, CO 80435
PERMIT NUMBER: Planning Case Number 2018.001

Architect Respondent: Studio PBA, Inc
Kathy Parker, Project Architect
kparker@studiopba.com
720-376-6845

Dear Ms. McDonald,

Below please find narrative responses to your comments dated March 28, 2018 on the above referenced project. Thank you for your review.

1. Building Height exceeds 30 feet. The proposed aerial apparatus access road entrance on the Southwest side does not meet the minimum requirement of 26 feet, exclusive of shoulders.
 - a. RESPONSE: Drive aisle width will be changed to 26 feet, exclusive of shoulders.
2. As per previous discussions, the aerial apparatus access road on the Northeast side leading from Lake Dillon Drive is greater than 150 feet. Please provide documentation on when a aerial apparatus turn around will be installed.
 - a. RESPONSE: See attached Sheet A021 Site Plan which documents that IFC Required Hose Pull distances can be met with a truck driving only 150' down the public ROW on the north side of the building. Therefore, no Turnaround should be required.
3. Provide an approved pathway/sidewalk on the North side of the structure.
 - a. RESPONSE: See attached Sheet C4 Grading Plan which documents a sidewalk leading from the Lake Dillon Drive public sidewalk, along the north side of the building, separate from the 40' public ROW. This sidewalk is 5' wide, and provides pedestrian and fire department access to the building entrance/egress on Level 3.
4. Fire lanes with approved signs will be required along the southwest parking area and garage entrances. See the Fire Department for details on approved signs and spacing.
 - a. RESPONSE: Noted. We will provide fire lanes and signage where required.
5. On page PUD 104, it does not show which stairs access the roof. Please have the developer provide details on the stairs and roof access.
 - a. RESPONSE: Per IBC 2015, 1011.12, in buildings without an occupied roof, a stair all the way to the roof is not required, and roof access can be accomplished via an alternating tread device or ladder through a roof hatch of 16 SF. This hatch will be provided in the roof of Stair #2 (See attached Sheet A021 and A117 Roof Plan for stair location).
However, the developer may choose to provide stair access all the way to the roof surface via roof penthouse.
6. The Fire Command Center shown on page PUD 101 does not meet minimum requirements of the IFC. It shall be a separate room from the riser room. Please have the developer contact the fire department to discuss the specific requirements of the room layout and access door location.
 - a. RESPONSE: Noted. Architect will alter the building layout as required to provide code compliant, and Fire Department approved, Fire Command room and sprinkler riser rooms.

Date: 03.30.2018

Page 2

7. A construction permit through the fire department is required for this project.
 - a. RESPONSE: Noted.
8. Based on size and occupancy, this project shall require an approved fire sprinkler system for the building. Please advise the developer to size the waterline into the building to meet fire sprinkler and domestic water demand accordingly. Where does the fire sprinkler line enter building?
 - a. RESPONSE: Building will be fully sprinklered per NFPA 13. Neither domestic water nor Fire Sprinkler loads have not been calculated yet. Fire line should enter building at/near the water entry room, into the fire pump room. FDC location is to be determined, based on requirements of local AHJ.
9. The proposed building will require the following life safety systems: fire sprinklers, fire alarm and interconnected dry fire standpipe.
 - a. RESPONSE: Noted. These will be deferred submittals along with Building Permit submittal. Architect and owner and Fire Sprinkler/Alarm design engineers will confer with Fire Department during design.
10. The fire standpipe fire department connection (FDC) requires a fire hydrant within 100 feet of the connection.
 - a. RESPONSE: Noted. Civil Engineer will provide design that satisfies IFC and Fire Department requirements.
11. A fire protection engineer should evaluate the need for a fire pump for the proposed structure based on available city water supply.
 - a. RESPONSE: Noted. A fire protection engineer will be engaged to design the system, and will determine the need for a fire pump. We are currently assuming that a fire pump will be provided, and will design appropriate space and fire separation inside the building.
12. The commercial kitchen cooking hood in the proposed restaurant may require an approved fire suppression system.
 - a. RESPONSE: Noted. Code compliant kitchen equipment, including hood(s), will be provided.
13. Based on the size of the building and type of construction and radio signal strength in the building, an emergency responder radio amplification system may be required.
 - a. RESPONSE: Noted. Radio signal strength will be tested for compliance and amplification system will be added if required.
14. The FD suggests a meeting with developer and contractor to discuss the fire code and life safety systems requirements for the building.
 - a. RESPONSE: Agreed. We will schedule a meeting as soon as we kick off our Design Development phase of construction documents.



Feel free to call with any questions or comments.

Sincerely,

Kathy Parker
Architect, Project Manager



VICINITY MAP - N.T.S.
DILLON, COLORADO

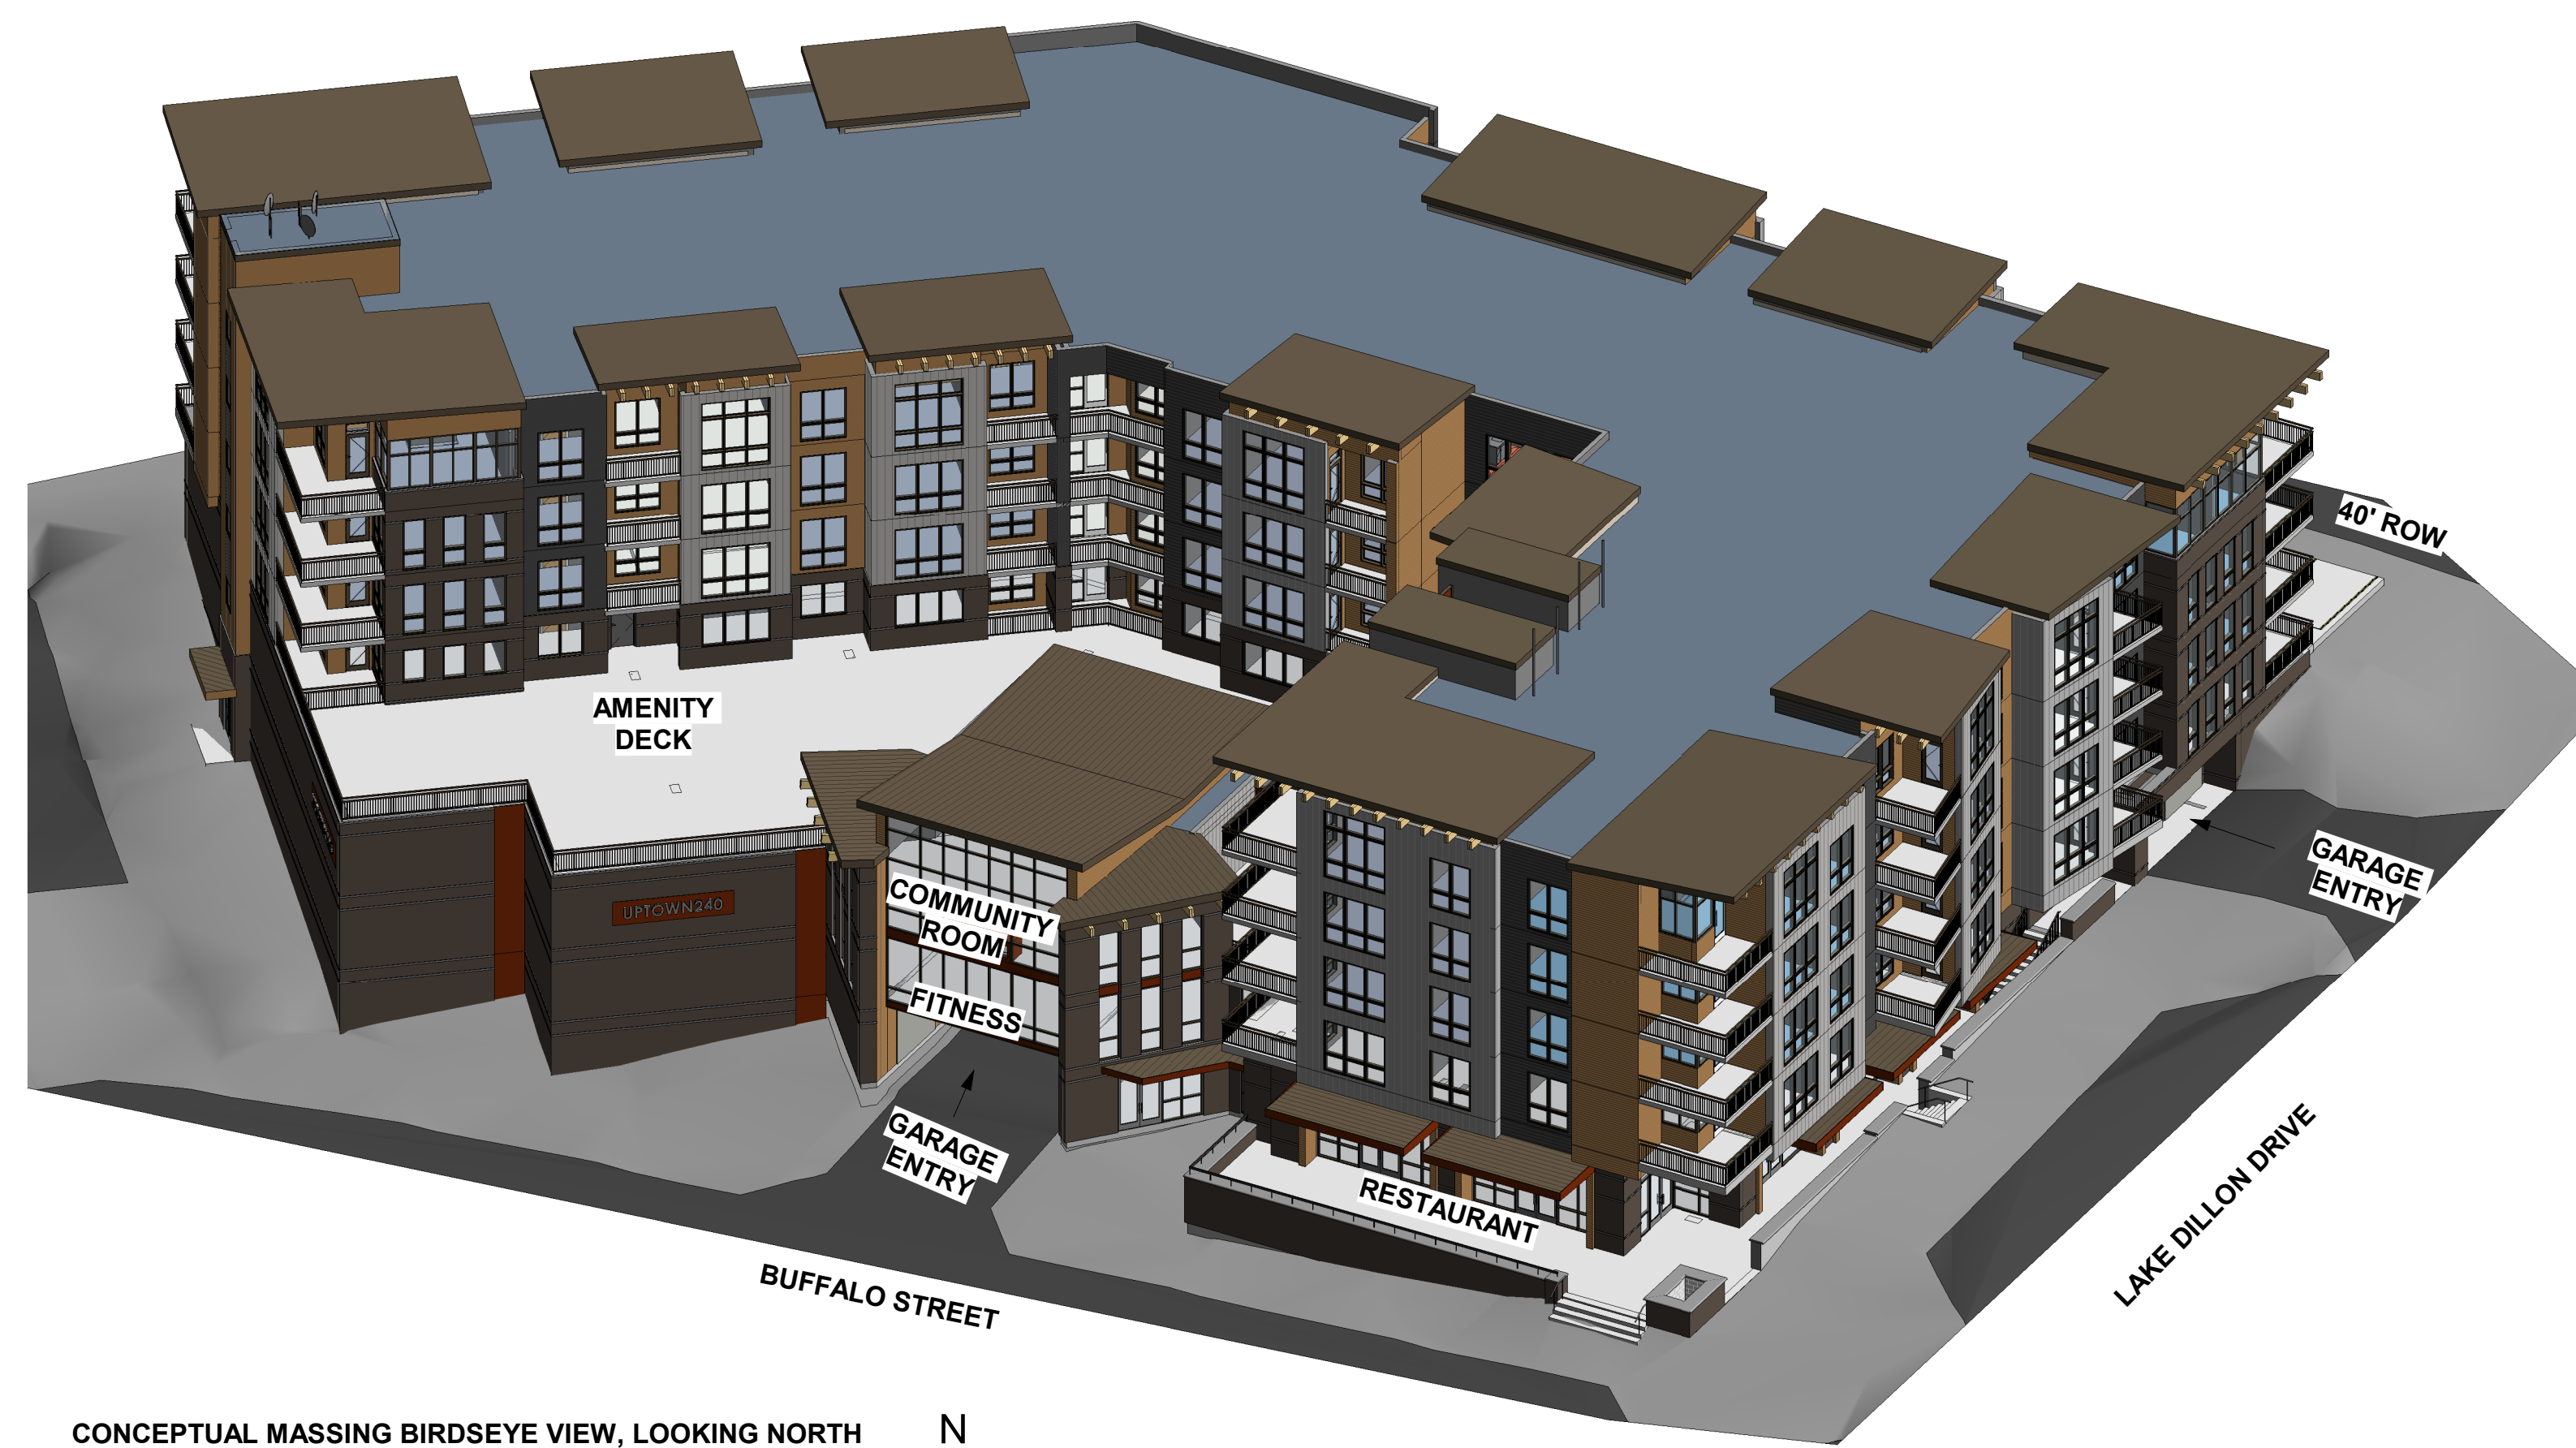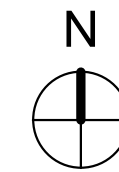

CONCEPTUAL MASSING BIRDSEYE VIEW, LOOKING NORTH



SHEET INDEX		
SHEET NAME	SHEET NUMBER	SCHEMATIC DESIGN
COVER SHEET	A000	•
SHEET INDEX / PROJECT INFO	A001	•
PROJECT ABBREVIATIONS / GENERAL NOTES	A010	•
SITE PLAN	A021	•
PROJECT INFORMATION	A031	•
WALL TYPE ASSEMBLIES	A061	•
WALL TYPE ASSEMBLIES	A062	•
FLOOR, CEILING, ROOF TYPE ASSEMBLIES	A063	•
TYPICAL FRR WALL DETAILS & TRANSITIONS	A064	•
TYPICAL FRR - HSS COLUMNS AND WF BEAMS	A065	•
UNIT COMPARTMENTALIZATION	A066	•
OVERALL PLAN - LEVEL 1B	A110	•
OVERALL PLAN - LEVEL 1	A111	•
OVERALL PLAN - LEVEL 2	A112	•
OVERALL PLAN - LEVEL 3	A113	•
OVERALL PLAN - LEVEL 4-6	A114	•
OVERALL ROOF PLAN	A117	•
BUILDING ELEVATIONS	A201	•
BUILDING ELEVATIONS	A202	•
BUILDING ELEVATIONS	A203	•
BUILDING ELEVATIONS	A204	•
ENLARGED UNIT PLANS - UNIT S1	A301	•
ENLARGED UNIT PLANS - UNIT S2	A302	•
ENLARGED UNIT PLANS - UNIT A1	A303	•
ENLARGED UNIT PLANS - UNIT A2	A304	•
ENLARGED UNIT PLANS - UNIT A2 ALT 1	A305	•
ENLARGED UNIT PLANS - UNIT A3	A306	•
ENLARGED UNIT PLANS - UNIT B1	A307	•
ENLARGED UNIT PLANS - UNIT B2	A308	•
ENLARGED UNIT PLANS - UNIT B2 ALT 1	A309	•
ENLARGED UNIT PLANS - UNIT B3	A310	•
ENLARGED UNIT PLANS - UNIT B3 ALT 1	A311	•
ENLARGED UNIT PLANS - UNIT C1	A312	•
BUILDING SECTIONS	A501	•
BUILDING SECTIONS	A502	•
WALL SECTIONS	A511	•
WALL SECTIONS	A512	•
DOOR SCHEDULE	A801	•
WINDOW SCHEDULE	A811	•
STOREFRONT SCHEDULE	A821	•
STOREFRONT SCHEDULE	A822	•
STOREFRONT SCHEDULE	A823	•
STOREFRONT SCHEDULE	A824	•
ACCESSIBILITY DETAILS - UNITS AND PUBLIC AREAS	A901	•
ACCESSIBILITY DETAILS - UNITS ONLY	A902	•
ACCESSIBILITY DETAILS - UNITS ONLY	A903	•
ACCESSIBILITY DETAILS - UNITS ONLY	A904	•
ACCESSIBILITY DETAILS - UNITS ONLY	A905	•
ACCESSIBILITY DETAILS - PUBLIC AREAS ONLY	A906	•
ACCESSIBILITY DETAILS - PUBLIC AREAS ONLY	A907	•
ACCESSIBILITY DETAILS - PUBLIC AREAS ONLY	A908	•

51

UPTOWN240

IVANO OTTOBORGO
240 LAKE DILLON DR.
DILLON, CO 80435

PH: 970-977-7310
EMAIL: igad@msn.com

studio
PBA
1575 GULPH STREET DENVER, CO 80218
PH: 303.592.2904 FX: 303.592.8387
www.studiopba.com

UPTOWN240

240 LAKE DILLON DRIVE
DILLON, COLORADO 80435

THESE DRAWINGS ARE INCOMPLETE AND ARE INTENDED FOR CONVEYING DESIGN SYSTEM CONCEPTS. ANY PRICING OR BUDGETING PERFORMED WITH THESE DRAWINGS MUST CARRY A CONTINGENCY TO COVER WHAT ITEMS MAY CHANGE OR BE ADDED AS THE DESIGN PROCESS IS COMPLETED.

No.	Description	Date

CURRENT PHASE

SCHEMATIC DESIGN

ISSUE DATE
03/09/2018

KEY PLAN

SHEET TITLE
SHEET INDEX /
PROJECT INFO

SHEET NUMBER

A001

ARCHITECT'S PROJECT NUMBER Project Number

GENERAL NOTES

A. WHERE SPECIFIC MATERIALS ARE CALLED OUT IN THE DRAWINGS, THESE PRODUCTS SHALL BE INSTALLED AS A PROPRIETARY ITEM REQUIREMENT AS THE BASIS OF DESIGN. THE ELEMENTS OF CONSTRUCTION SHOWN HEREIN ARE REPRESENTATIVE OF THE BUILDING CODE REQUIRED ITEMS FOR ASSEMBLIES, FIRE AND SMOKE RATINGS, AND SEPARATION REQUIREMENTS AND SHALL BE ADHERED TO.

B. DRAWINGS AND DETAILS SHOWN IN THE DRAWINGS DEMONSTRATE MINIMUM REQUIREMENTS FOR THE WORK. SUBSTITUTIONS AND/OR ALTERNATE METHODS MAY BE APPLICABLE, AND INTERPRETATIONS ARE SUBJECT TO THE DISCRETION OF THE OWNER/ CONTRACTOR, AND MAY BE SUBJECT TO APPROVAL BY THE AUTHORITY HAVING JURISDICTION.

C. ALL WORK IS SUBJECT TO APPROVAL OF THE LOCAL MUNICIPALITIES, AUTHORITIES HAVING JURISDICTION AND AMERICANS WITH DISABILITIES ACT. NOTE THAT CRITICAL CLEARANCES ARE STATED AND ARE A REQUIRED COMPONENT OF THIS WORK, AND SHALL BE ADHERED TO DURING LAYOUT AND CONSTRUCTION OF THE ASSEMBLIES.

D. ALL WORK AND MATERIALS SHALL BE INSTALLED PER MANUFACTURERS WRITTEN INSTRUCTIONS, SPECIFICATIONS, INTENDED USAGE AND IN ACCORDANCE WITH ALL INDUSTRY STANDARDS, REGULATORY AND ADVISORY ORGANIZATIONS OR COUNCILS. ADDITIONALLY, CONTRACTOR SHALL PROVIDE AND INSTALL FULL SYSTEMS OF ANY COMPONENTS UTILIZED IN THE WORK, TO PROVIDE FULLY FUNCTIONING COMPLETE, COMPATIBLE AND WARRANTABLE ASSEMBLY OF THE WORK.

E. CONTRACTOR SHALL BE RESPONSIBLE FOR ALL MEANS AND METHODS OF THE WORK, WHICH SHALL INCLUDE MEANS AND METHODS OF FASTENING ITEMS OF ASSEMBLIES TO OTHER COMPONENTS OF THE WORK. INSTALL SIZE, QUANTITY AND TYPE OF FASTENERS INDICATED, AS REQUIRED BY INDUSTRY STANDARDS, MANUFACTURER REQUIREMENTS OR AS REQUIRED BY LOCAL CODES AND ORDINANCES. WHERE ROUGH CARPENTRY IS EXPOSED TO WEATHER, IN GROUND CONTACT, PRESSURE TREATED, FIRE RETARDANT TREATED LUMBER OR IN AREA OF HIGH RELATIVE HUMIDITY, INSTALL FASTENERS WITH HOT-DIP ZINC COATING. ELECTRO GALVANIZING OF FASTENERS IS NOT PERMITTED.

F. DETAILS SHOWN MAY BE GENERAL IN NATURE AND MAY BE REQUIRED IN SIMILAR LOCATIONS, WHETHER INDICATED OR NOT. IN EVENT OF INCONSISTENCY OR LACK OF CLARITY, SEEK INTERPRETATION FROM ARCHITECT.

G. ELEVATIONS INDICATED ARE TO TOP OF PLATE, TOP OF STEEL, TOP OF GRADE, TOP OF CONCRETE, TOP OF MASONRY, OR TOP OF UNDERSIDE OF CEILING, UNLESS NOTED OTHERWISE.

H. THE CONTRACTOR SHALL BE RESPONSIBLE FOR LOCATING AND INSTALLING BACKING MATERIALS THAT ARE ADEQUATE TO THE PURPOSE AS REQUIRED TO INSTALL OTHER ITEMS OF CONSTRUCTION AND FOR ALL WALL MOUNTED ITEMS.

I. DRAWINGS WERE PREPARED USING PRODUCT SPECIFIC INFORMATION AND CONFIGURATIONS. ACTUAL DIMENSIONS AND DETAILS FOR SPECIFICALLY SELECTED MATERIALS MAY CHANGE BEFORE INCORPORATION INTO THE WORK, OR AS A RESULT OF SUBSTITUTIONS, CONTRACTOR SHALL VERIFY INSTALLATION REQUIREMENTS AND CLEARANCES BEFORE INCORPORATION INTO THE WORK, AND SHALL BE RESPONSIBLE FOR ACCOMMODATING ANY CHANGES TO OTHER MATERIALS THAT ARE NECESSARY DUE TO DIFFERENCES OR SUBSTITUTIONS.

J. BOTH TYPICAL AND UNIQUE DETAILS OF CONSTRUCTION ARE INCLUDED IN THE DRAWINGS. DETAIL CONDITIONS WHICH ARE SIMILAR IN CHARACTER, APPEARANCE AND DESIRED AESTHETIC ARE NOT NECESSARILY DRAWN. WHERE SPECIFIC DIMENSIONS, DETAILS AND DESIGN INTENT CANNOT BE DETERMINED SEEK CLARIFICATION FROM ARCHITECT PRIOR TO INSTALLATION IN THE WORK.

K. ALL WORK SHALL COMPLY WITH THE LATEST REQUIREMENTS OF UNDERWRITERS LABORATORIES (U.L), GYPSUM ASSOCIATION (G.A.) AND BOTH THE AMERICANS WITH DISABILITIES ACT AND FAIR HOUSING ACT FOR ACCESSIBILITY, AS WELL AS APPLICABLE REQUIREMENTS OF FEDERAL, STATE AND MUNICIPAL AUTHORITIES HAVING JURISDICTION FOR ADA AND BUILDING CODE COMPLIANCE.

L. ALL DRAWINGS AND SPECIFICATIONS ARE COMPLIMENTARY, AND WHAT IS REQUIRED BY ONE, SHALL BE BINDING AS IF REQUIRED BY ALL. IN THE EVENT OF INCONSISTENCIES BETWEEN THE DRAWINGS PROVIDED BY THE ARCHITECT AND CONSULTANTS, THE CONTRACTOR SHALL SEEK CLARIFICATION OR INTERPRETATION FROM THE ARCHITECT. WHERE INCONSISTENCIES ARE NOT QUALIFIED, THE CONTRACTOR SHALL PROVIDE THE STRICTER QUALITY OF THE WORK.

M. CONTRACTOR SHALL ACQUIRE ALL PERMITS, INSPECTIONS AND SERVICES TO PROVIDE THE WORK.

N. AT THE INTERFACE OF DISSIMILAR MATERIALS, INSTALL SEALANT JOINTS AS DETAILED IN THE DRAWINGS. FILLET SEALANT JOINTS MAY BE INSTALLED AT THE INTERFACE OF DISSIMILAR MATERIALS AT INTERIOR CONDITIONS. REFER TO DRAWINGS FOR EXTERIOR JOINT DETAILING REQUIRING BACKER RODS.

O. INSTALL 5/8 INCH MOISTURE RESISTANT TYPE GYPSUM BOARD AT ALL WET AREAS, FOR A DISTANCE OF 2'-0" HORIZONTALLY IN EACH DIRECTION, FROM CENTERLINE OF WET FIXTURES, AND TO A HEIGHT OF 60 INCHES ABOVE FINISH FLOOR.

P. INSTALL FIRE RATED ENCLOSURES AROUND ALL OUTLETS, BOXES, PIPING, DUCTWORK, LIGHTING, ETC. THAT ARE RECESSED IN RATED WALL ASSEMBLIES.

Q. CONTRACTOR SHALL FIELD VERIFY ALL MEASUREMENTS AND OPENINGS PRIOR TO INSTALLATION OF SUBSEQUENT WORK.

R. ALL CONTRACTORS AND MATERIAL SUPPLIERS ARE RESPONSIBLE FOR REVIEWING THE ENTIRE CONTRACT DOCUMENTS PRIOR TO SUBMITTING BIDS OR PROPOSALS FOR THE WORK. SUBMISSION OF BIDS AND PROPOSALS SHALL BE INCONTROVERTIBLE EVIDENCE THAT CONTRACTORS HAVE REVIEWED ALL DOCUMENTS AND SUBMITTED BIDS TO COVER ALL SCOPES OF THE WORK, INCLUDING INTERFACE AND COORDINATION WITH OTHER TRADES.

S. CONTRACTOR AND SUB CONTRACTORS SHALL BE RESPONSIBLE FOR COORDINATING THEIR WORK WITH THE WORK OF ALL OTHER TRADES. CONTRACTORS SHALL PROVIDE A FULLY COMPLETE AND FUNCTIONING PROJECT, INFRASTRUCTURE AND BUILDING SYSTEMS INCLUDING ALL ACCESSORIES, CONTROLS, SUB AND SUPPORT SYSTEMS REQUIRED FOR THE FUNCTIONAL OPERATION OF NECESSARY SYSTEMS.

T. THE CONTRACTOR SHALL BE SOLELY RESPONSIBLE FOR ALL PRODUCT AND MATERIAL INSTALLATION METHODS, DETAILS AND REQUIREMENTS IN ORDER TO MEET INSTALLATION AND WARRANTY REQUIREMENTS OF PRODUCT MANUFACTURER. THIS PROVISION SHALL ALSO INCLUDE ANY REQUIRED SUBSTRATE PREPARATION, AND COMMENCEMENT OF THE WORK SHALL CONSTITUTE ACCEPTANCE AND SUITABILITY OF THE SUBSTRATE FOR WORK TO BE PERFORMED AND INSTALLED.

U. PROJECT REQUIREMENTS FOR PERIMETER OR UNDER DRAIN SYSTEMS MAY APPLY, AND SHALL BE COORDINATED WITH GEOTECHNICAL REPORT AND THE PROVISIONS OF BELOW GRADE WATERPROOFING AND DRAINAGE.

V. ALL DIMENSIONS SHALL TAKE PRECEDENCE OVER SCALES SHOWN ON PLANS, SECTIONS, DETAILS. DO NOT SCALE DRAWINGS.

W. DESIGN OF LOW VOLTAGE AND ACCESS CONTROL SYSTEMS IS DESIGN/BUILD BY OTHERS (GENERAL CONTRACTOR & ITS SUBCONTRACTORS).

X. CONTRACTOR SHALL PROVIDE MOCKUPS PER PROJECT MANUAL, SECTION 014330

Y. NOT USED

Z. TO THE BEST OF OUR KNOWLEDGE, SKILL, AND BELIEF, THIS PROJECT HAS BEEN DESIGNED ACCORDING TO THE REQUIREMENTS OF THE FAIR HOUSING ACT DESIGN MANUAL.

AA. THE CONTRACTOR SHALL NOT QUALIFY, ALTER, OR OTHERWISE MODIFY, THE SCOPE OF WORK AS NARRATED AND REQUIRED BY THE CONTRACT DOCUMENTS, WITHOUT THE WRITTEN CONSENT, AND APPROVAL OF THE ARCHITECT.

SUBMITTAL GENERAL NOTES

THE CONTRACTOR SHALL SUBMIT A SUBMITTAL SCHEDULE TO THE ARCHITECT WITHIN 30 CALENDAR DAYS OF THE NOTICE TO PROCEED. SCHEDULE SHALL COVER ALL REQUIRED SUBMITTALS, IN ACCORDANCE WITH ONLY THOSE COMPONENTS REQUIRED BY THE WORK. THE SUBMITTAL SCHEDULE WILL BE REVIEWED BY THE ARCHITECT, AND RETURNED WITH THE APPROPRIATE ACTION NOTED, AND AN EVALUATION IF THE SUBMITTAL SCHEDULE AND COMPONENTS ARE APPROPRIATE AND WITHIN REASON OF THE ARCHITECTS SCHEDULE.

SUBMITTALS SUBMITTED OUT OF SEQUENCE OF THE SUBMITTAL SCHEDULE OR AS SUBSTITUTIONS TO THE BASIS OF DESIGN WILL NOT BE REVIEWED BY THE ARCHITECT WITHOUT SCHEDULE EXTENSIONS OR ADDITIONAL COMPENSATION FROM THE CONTRACTOR. ANY ADDITIONAL EXPENSES INCURRED BY THE ARCHITECT WILL BE BILL TO THE CONTRACTOR AT THE ARCHITECTS STANDARD HOURLY RATE.

SUBMITTALS SUBMITTED OUTSIDE OF THE SCOPE OF WORK OR STANDARD COMPONENTS THEREOF, WILL NOT BE REVIEWED BY THE ARCHITECT WITHOUT SCHEDULE EXTENSIONS OR ADDITIONAL COMPENSATION FROM THE CONTRACTOR. THIS SHALL INCLUDE, BUT NOT BE LIMITED TO, SUBMITTALS SUBMITTED BY THE CONTRACTOR AS A RESULT OF REPAIRS, INCORRECT SUBMITTALS, DEFICIENCIES, CORRECTIVE ACTIONS, SUBSTITUTIONS, ITEMS ABOVE OR BEYOND THE COMPONENTS REQUIRED BY THE BASIS OF DESIGN, AND SUBMITTALS SUBMITTED MULTIPLE TIMES.

THE ARCHITECTS REVIEW OF SUBMITTALS AND SHOP DRAWINGS IS FOR GENERAL CONFORMANCE WITH THE CONTRACT DOCUMENTS AND SCOPE OF WORK ONLY. THE CONTRACTOR IS RESPONSIBLE FOR REVIEW OF DIMENSIONS, QUANTITIES AND COORDINATION WITH OTHER TRADES AND COMPONENTS OF THE WORK.

SUBMITTALS SUBMITTED WITHOUT THE CONTRACTORS REVIEW STAMP AND PARTIAL OR INCOMPLETE SUBMITTALS CANNOT BE REVIEWED BY THE ARCHITECT OR DESIGN TEAM.

SUBMITTALS SHALL BE ENUMERATED IN ACCORDANCE WITH THE CSI FORMAT AND TABLE OF CONTENTS SPECIFICATION REFERENCE NUMBER.

WORK FURNISHED OR INSTALLED BY THE CONTRACTOR IN ADVANCE OF REVIEWED SUBMITTALS, SHALL BE AT THE CONTRACTORS SOLE RISK, AND MAY BE REJECTED BY THE ARCHITECT OR DESIGN TEAM.

THE ARCHITECT WILL REVIEW ONE COPY OF SUBMITTALS AND RETURN ONE COPY TO THE CONTRACTOR.

THE ARCHITECT WILL STRIVE TO PROCESS SUBMITTALS AS QUICKLY AS POSSIBLE, AND WITHIN 10 BUSINESS DAYS. HOWEVER, THE CONTRACTOR IS SPECIFICALLY CAUTIONED THAT THE FOLLOWING SUBMITTALS REQUIRE ADDITIONAL REVIEW TIME:

- FLOOR JOIST SHOP DRAWINGS.
- ROOF TRUSS SHOP DRAWINGS.
- COUNTERTOP SHOP DRAWINGS.
- CABINETRY SHOP DRAWINGS AND PRODUCT DATA.
- PRE CAST CONCRETE SHOP DRAWINGS.
- WINDOW, DOOR AND HARDWARE SHOP DRAWINGS.
- STEEL AND REBAR SHOP DRAWINGS.
- MECHANICAL, ELECTRICAL AND PLUMBING SYSTEMS, PRODUCT DATA AND SHOP DRAWINGS.
- SUBSTITUTIONS OR ANY ITEM SUBMITTED NOT ORIGINALLY REQUIRED BY THE BASIS OF DESIGN.


ABBREVIATIONS

AB ANCHOR BOLT	OA OVERALL
ACOUS ACOUSTICAL	O/C ON CENTER(S)
ADA AMERICANS WITH DISABILITY ACT	OD OUTSIDE DIAMETER
AFB ABOVE FINISHED FLOOR	OH OPPOSITE HAND/OVERHEAD
ALT ABOVE FLOOR LINE	OPF OPPOSITE
ALUM ALUMINUM	OSF OUTSIDE FACE
ANSI AMERICAN NATIONAL STANDARDS	OSB ORIENTED STRAND BOARD
APPROX INSTITUTE	OZ OUNCE(S)
ARCH APPROXIMATE	PART. PARTITION
AUTO ARCHITECTURAL	P.C. PULL CHAIN
BD BOARD	PEDESTAL PEDESTAL
BKG BACKING	PG PAINT GRADE
BLDG BUILDING	PH PANIC HARDWARE
BLK BLOCK	PL PROPERTY LINE
BM BEAM	PLM PLASTIC LAMINATE
B.O. BOTTOM OF	PLT LN PLATE LINE
BOT BOTTOM	PLUM PLUMBING
BRG BEARING	PLWD PLYWOOD
BTU BRITISH THERMAL UNIT	PN PANEL
CAB CABINET	PR PAIR
C/C CENTER TO CENTER	PRO PROJECTION
CFM CUBIC FEET PER MINUTE	PSF POUNDS PER SQUARE FOOT
CHAN CHANNEL	PSI POUNDS PER SQUARE INCH
CIP CAST IN PLACE	PT PRESSURE TREATED / POST
CH CONTROL JOINT	PTS POST TENSION SLAB
CL CENTER LINE	PVC POLYVINYL CHLORIDE
CLG CEILING	PW PARTY WALL
CLC CLOSER	R ROD
CLR CLEAR	RD ROOF DRAIN
CNTR COUNTER	REF REFERENCE
CMU CONCRETE MASONRY UNIT	REFR REFRIGERATOR
CO CLEAN OUT	REINF REINFORCE(D), (ING)
COL COLLUM	REQD REQUIRED
CONC CONCRETE	REQS REQUIREMENTS
CONT CONTINUOUS, CONTINUE	RES RESILIENT
COMP COMPUTER/ COMPOSITE	REVS REVERSE(D)/REVISION
CPT CARPET	RM ROOM
CW COLD WATER	RS ROUGH SAWN
DF DRYER/DEPTH	S SHELF
DR DRINKING FOUNTAIN	SAN SANITARY
DH DOUBLE HUNG	S.C. SOLID CORE
DHW DOMESTIC HOT WATER	SCH SCHEDULE
DIAG DIAGONAL	SD STORM DRAIN
DIA DIAMETER	SEC SECTION
DISP DISPENSER/DISPOSAL	SH SQUARE FOOT/FEET
DN DOWN	SGD SLIDING GLASS DOOR
DR DRAWER	SHT SHEET
DTL DETAIL	SIM SIMILAR
DU DWELLING UNIT	SLP SLOPE
DV DIRECT VENT	SOG SLAB ON GRADE
DW DISHWASHER	SPEC SPECIFICATION(S)
DWG DRAWING	SPR SPRINKLER
EA EACH	SO SQUARE
EIFS EXTERIOR INSULATION FINISH SYSTEM	STOR STORAGE
EJ EXPANSION JOINT	STL STEEL
ELEC ELECTRIC(AL)	STRUC STRUCTURAL
ELEV ELEVATION/ELEVATOR	SUSP SUSPENDED
EQ EQUIVALENT	TB TOWEL BAR
EWC ELECT. WATER COOLER	TBD TO BE DETERMINED
EXIST EXISTING	TC TEMPERATURE CONTROL
EXT EXTERIOR	TELE TELEPHONE
EXP EXPANSION	TENT TENANT
FD FLOOR DRAIN	TEMP TEMPERED
FDC FIRE DEPARTMENT CONNECTION	T&G TONGUE AND GROOVED
FE FIRE EXTINGUISHER	THK THICKNESS)
FEC FIRE EXTINGUISHER CABINET	THRU THROUGH
FF FINISH FLOOR	T.O. TOP OF
FFE FINISH FLOOR ELEVATION	T.O.S. TOP OF SLAB
FG FIBERGLASS	TP TOILET PAPER
FLG FLANGE	TS TUBE STEEL
FLUOR FLUORESCENT	TYP TYPICAL
FND FOUNDATION	UBC UNIFORM BUILDING CODE
F.O.G. FACE OF GARAGE	UC UNDER COUNTER
F.O.S. FACE OF SLAB	UFC UNIFORM FIRE CODE
FP FIRE PLACE	UMC UNIFORM MECHANICAL CODE
FTG FOOTING	UNLESS NOTED OTHERWISE
FT FEET	UPC UNIFORM PLUMBING CODE
GA GAUGE	V VANITY
GAL GALLON	VCT VINYL COMPOSITE TILE
GALV GALVANIZED	VEST VESTIBULE
GC GENERAL CONTRACTOR	VERT VERTICAL
GRD GRADE	VIF VERIFY IN FIELD
GYP GYPSUM	VRS VARIES
GWB GYPSUM WALL BOARD	VTR VENT THROUGH ROOF
H HIGH/HEIGHT	W WASHER/WATER/WEST/WIDTH
HB HOSE BIB	W/ WITH
H.C. HOLLOW CORE	WC WATER CLOSET
HD HARD	WIC WALK IN CLOSET
HD BD HARD BOARD	W/O WITHOUT
HDCP HANDICAP ACCESSIBLE	WT WEIGHT
HDR HEADER	
HGT HEIGHT	
HM HOLLOW METAL	
HOLD HOLD OPEN	
HORZ HORIZONTAL	
HP HORSE POWER	
HR HOUR	
HS HORIZONTAL SLIDER	
HT HEIGHT	
H.T. HEAVY TIMBER	
HVAC HEATING VENTILATION AIR CONDITIONING	
HW HOT WATER	
HWC HOT WATER CIRCULATION	
HWL HOT WATER HEATER	
IBC INTERNATIONAL BUILDING CODE	
ID INSIDE DIAMETER	
IECC INTERNATIONAL ENERGY CONSERVATION CODE	
IFC INTERNATIONAL FIRE CODE	
IFGC INTERNATIONAL FUEL GAS CODE	
IMC INTERNATIONAL MECHANICAL CODE	
INC INCLUDE(D)	
INSUL INSULATION/INSULATING	
INT INTERIOR	
IPC INTERNATIONAL PLUMBING CODE	
JT JOINT	
L LENGTH	
LAND LANDSCAPE	
LAV LAVATORY	
LT LITE/LIGHT	
M MIRROR	
MAX MAXIMUM	
MC MEDICINE CABINET	
MDF MEDIUM DENSITY FIBERBOARD	
MECH MECHANICAL	
MFR MANUFACTURE(R)	
MICRO MICROWAVE	
MIN MINIMUM/MINUTE	
MISC MISCELLANEOUS	
MTL METAL	
N NORTH	
NEC NATIONAL ELECTRIC CODE	
NO NUMBER	
NIC NOT IN CONTRACT	
NTE NOT TO EXCEED	
NTS NOT TO SCALE	

MATERIAL KEY

SECTION	ELEVATION
CONCRETE	STANDING SEAM METAL
EARTH	STONE
GYPSUM BOARD / SAND / GROUT / MORTAR	LAP SIDING
INSULATION - BATT	
INSULATION - RIGID	
PLYWOOD	
WOOD BLOCKING	
WOOD CONTINUOUS	
CMU	

SYMBOL KEY

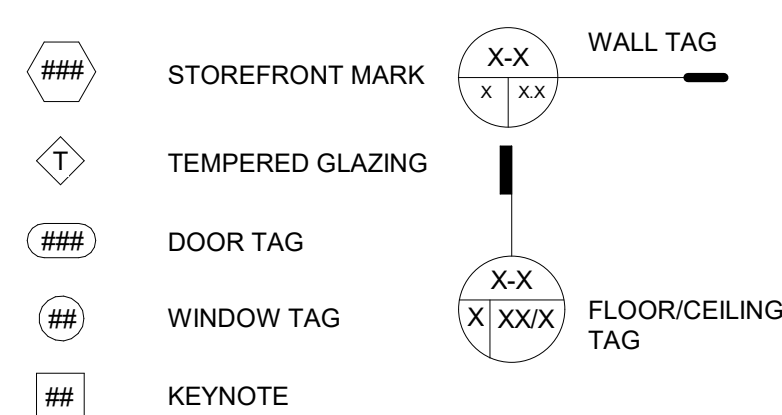

UPTOWN240

IVANO OTTOBORGO
240 LAKE DILLON DR.
DILLON, CO 80435
PH: 970-977-7310
EMAIL: ligad@msn.com



UPTOWN240

240 LAKE DILLON DRIVE
DILLON, COLORADO 80435

THESE DRAWINGS ARE INCOMPLETE AND ARE INTENDED FOR CONVEYING DESIGN SYSTEM CONCEPTS. ANY PRICING OR BUDGETING PERFORMED WITH THESE DRAWINGS MUST CARRY A CONTINGENCY TO COVER WHAT ITEMS MAY CHANGE OR BE ADDED AS THE DESIGN PROCESS IS COMPLETED.

No.	Description	Date

CURRENT PHASE

SCHEMATIC DESIGN

ISSUE DATE

03/09/2018

KEY PLAN

SHEET TITLE

PROJECT ABBREVIATIONS / GENERAL NOTES

SHEET NUMBER

A010


ARCHITECT'S PROJECT NUMBER Project Number

UPTOWN240

IVANO OTTOBORGO
240 LAKE DILLON DR.
DILLON, CO 80435
PH: 970-977-7310
EMAIL: igad@msn.com

studio
PBA
1575 GULPH STREET DENVER, CO 80218
PH: 303.592.2904 FX: 303.592.8387
www.studiopba.com

UPTOWN240
240 LAKE DILLON DRIVE
DILLON, COLORADO 80435

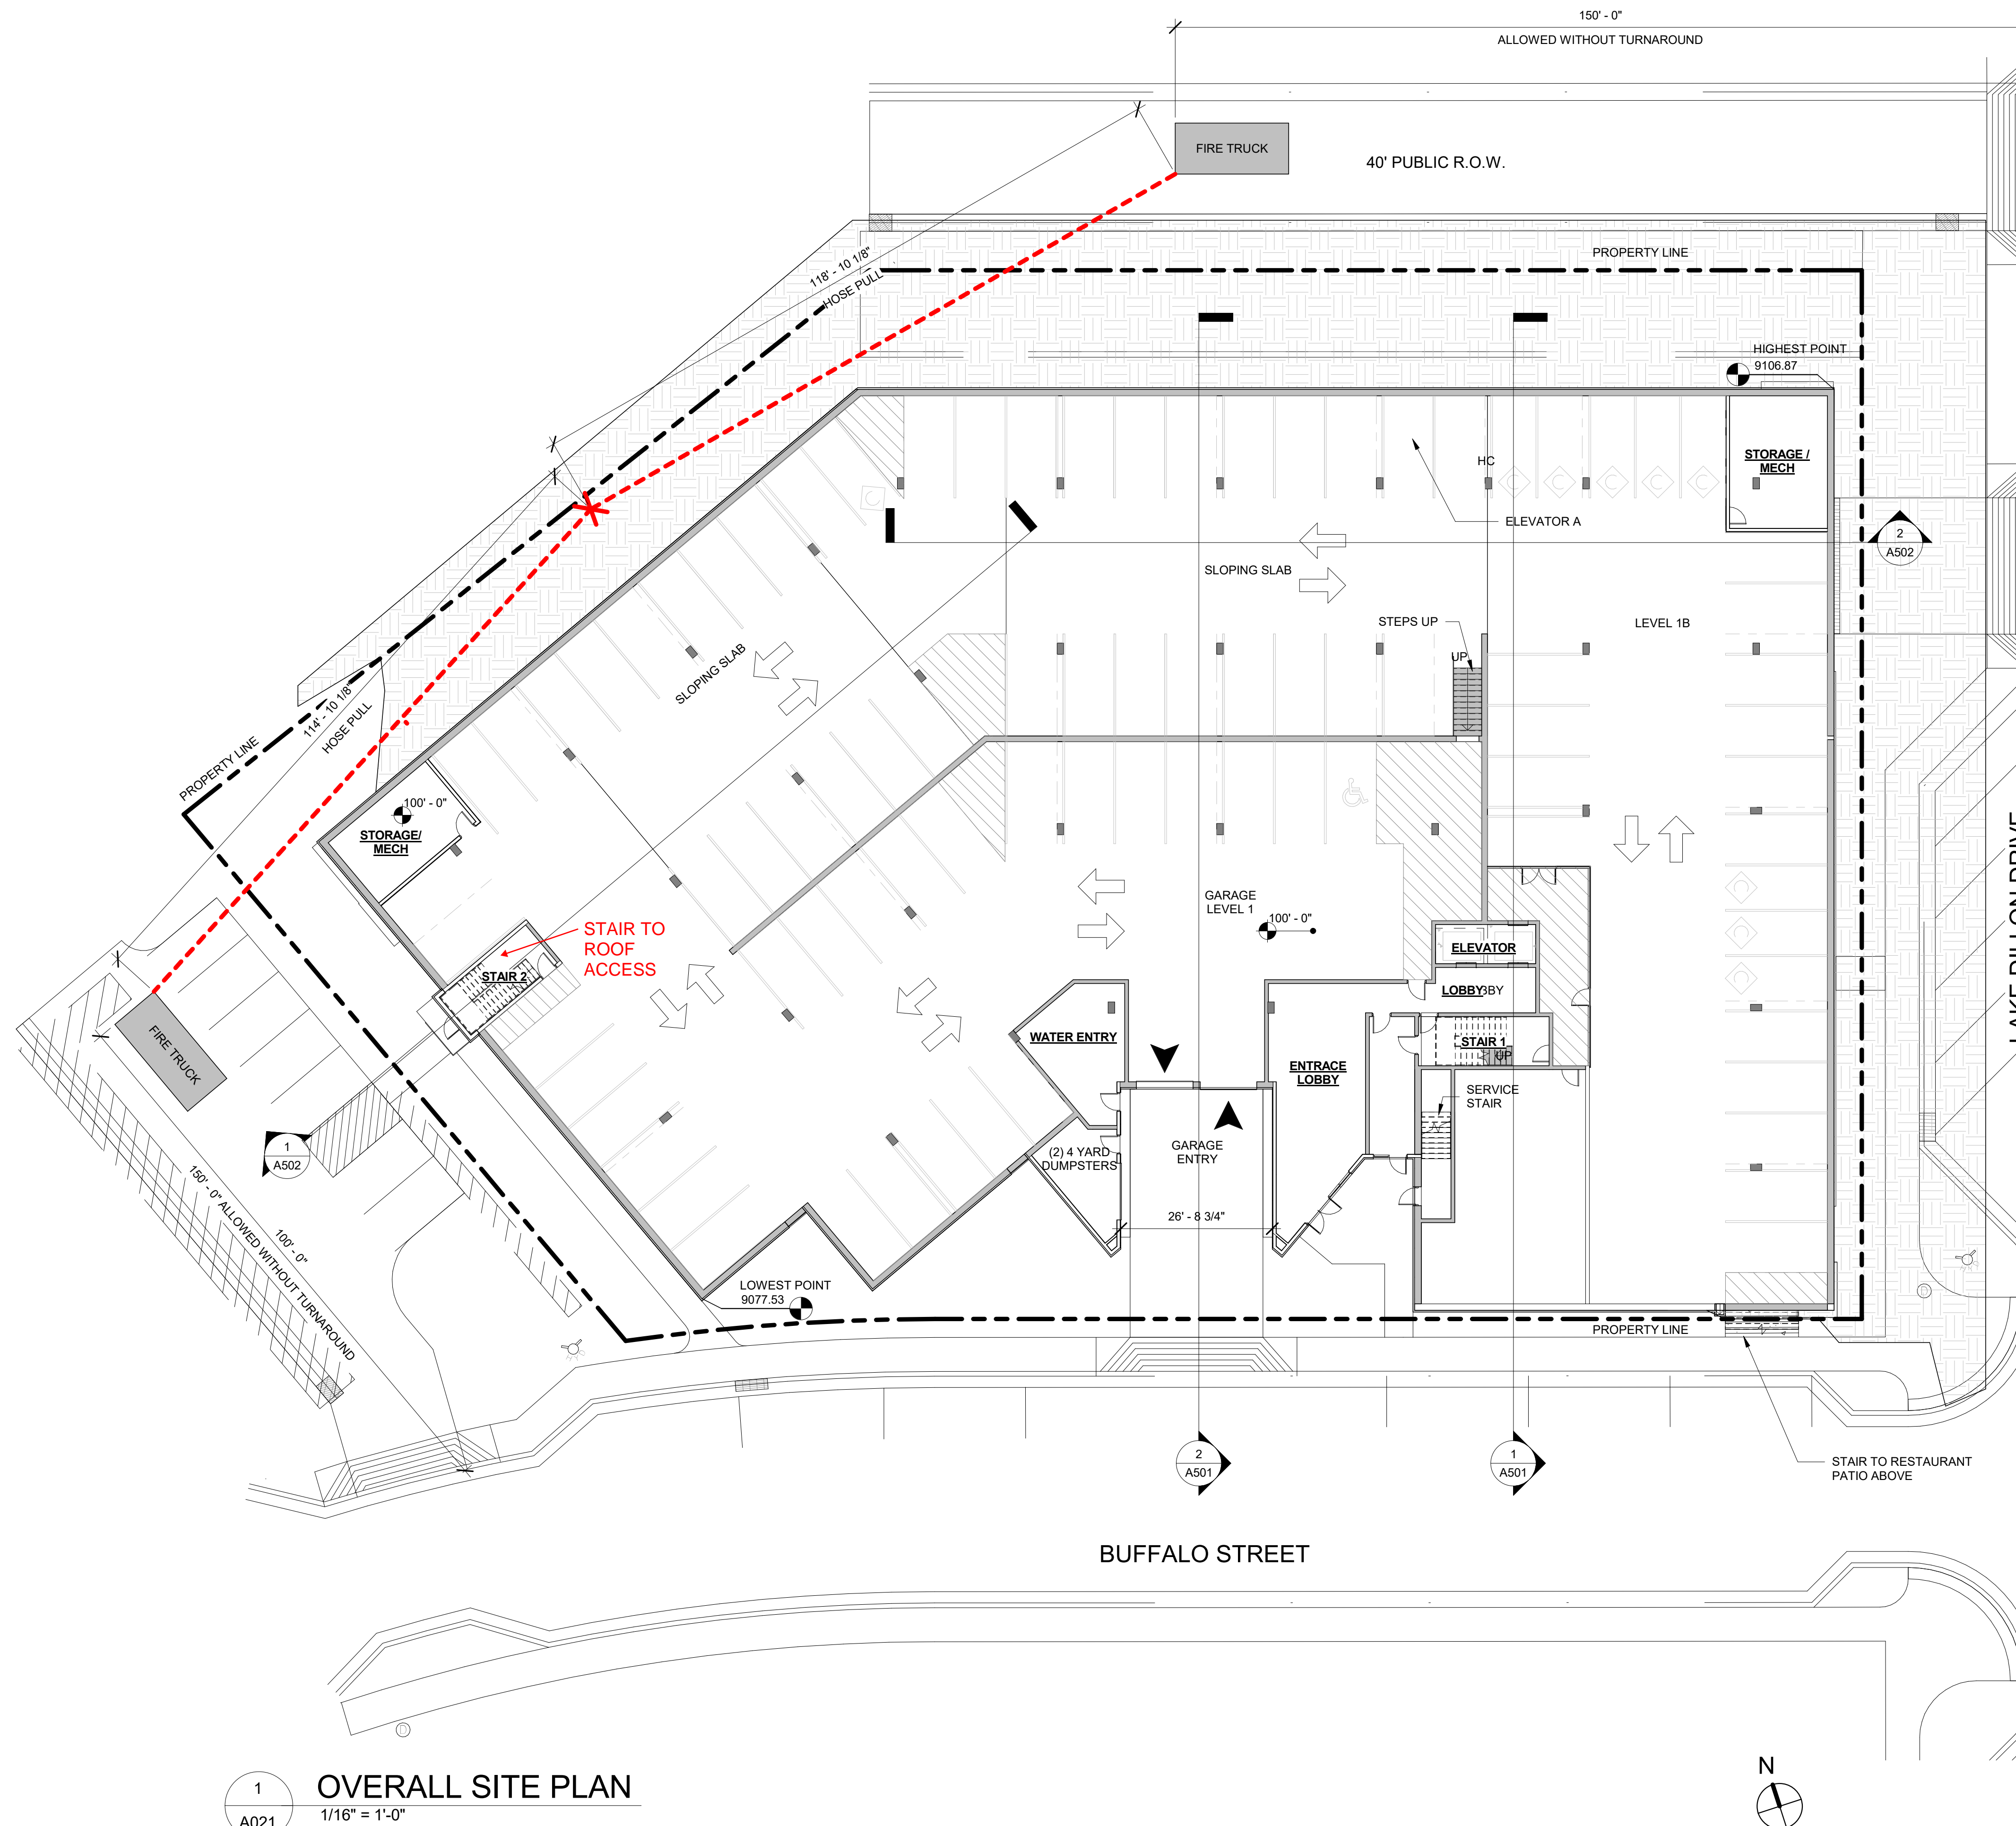

1
A021
OVERALL SITE PLAN
1/16" = 1'-0"

SITE PLAN GENERAL NOTES

- REFER TO CIVIL AND LANDSCAPE PLANS FOR SITE INFO NOT OTHERWISE NOTED.
- REFER TO CIVIL DRAWINGS FOR UTILITY LOCATIONS & CONNECTIONS.
- BLDG / SITE SIGNAGE TO BE BY SEPARATE SUBMITTAL.
- REFER TO CIVIL DRAWINGS FOR ACCESSIBLE ROUTE.
- REFER TO CIVIL OVERALL GRADING PLAN FOR GRADE CHANGES, STEPS IN BUILDINGS SLABS. ALSO SEE ARCH SLAB PLANS.
- REFER TO ELECTRICAL SITE PLAN FOR SITE LIGHTING LAYOUTS AND FIXTURES.
- PROVIDE KNOX BOX PER FIRE DEPT. VERIFY LOCATION WITH FIRE DEPT.


SITE PLAN LEGEND

- PROPERTY LINE
- - - - BUILDING SETBACK LINE
- ACCESSIBLE ROUTE / MEANS OF EGRESS
- ⊕ ACCESSIBLE PARKING SPACE OR TYPE A UNIT
- ▨ ACCESSIBLE PARKING AISLE
- ⊕ FIRE HYDRANT
- ▶ VEHICLE ENTRY/EXIT POINT
- ➡ VEHICLE DIRECTIONAL ARROW
- ▶ PEDESTRIAN ENTRY POINT
- ◊ COMPACT PARKING SPACE


THESE DRAWINGS ARE INCOMPLETE AND ARE INTENDED FOR CONVEYING DESIGN SYSTEM CONCEPTS. ANY PRICING OR BUDGETING PERFORMED WITH THESE DRAWINGS MUST CARRY A CONTINGENCY TO COVER WHAT ITEMS MAY CHANGE OR BE ADDED AS THE DESIGN PROCESS IS COMPLETED.

No.	Description	Date
CURRENT PHASE		
SCHEMATIC DESIGN		
ISSUE DATE		03/09/2018
KEY PLAN		
SHEET TITLE		SITE PLAN
SHEET NUMBER		A021
ARCHITECT'S PROJECT NUMBER Project Number		

COPYRIGHT © 2018 STUDIO PBA, INC. ALL RIGHTS RESERVED 3/9/2018 12:28:44 PM

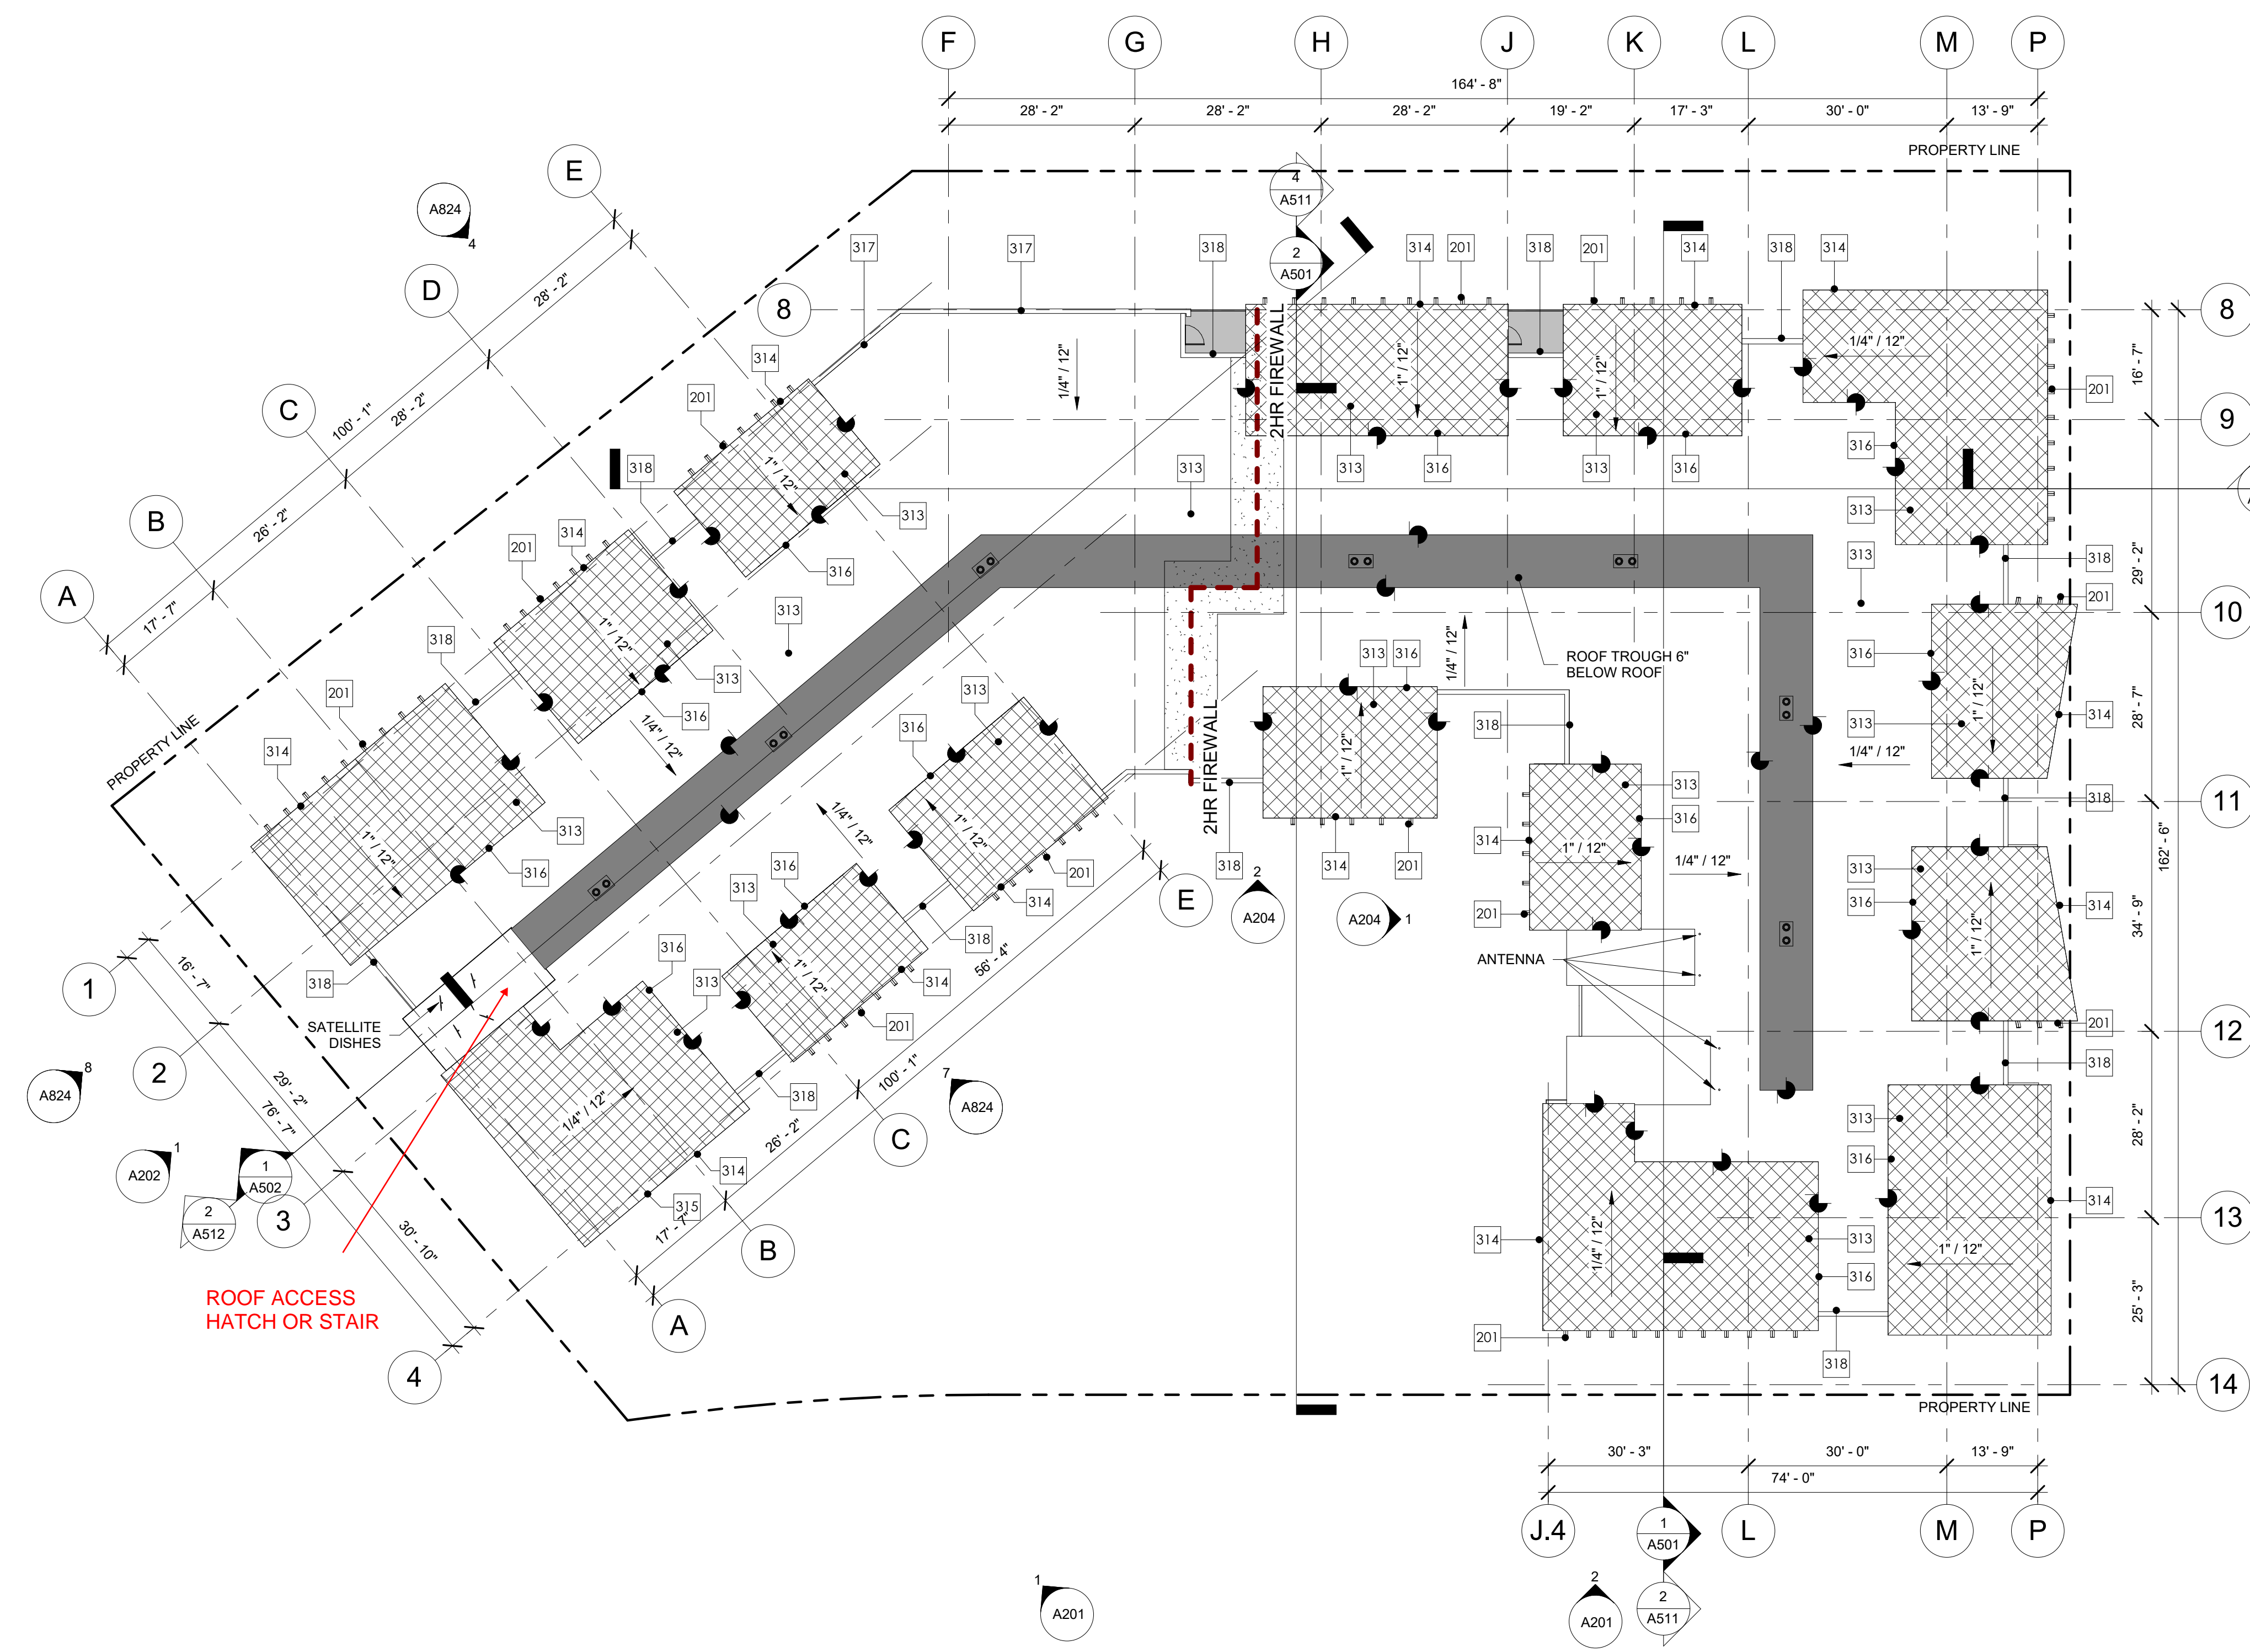

1 OVERALL LAYOUT - ROOF
 1/16" = 1'-0"

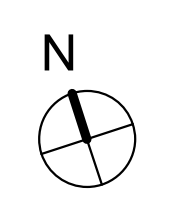

KEYNOTES	
#	DESCRIPTION
201	WOOD HEAVY TIMBER DECORATIVE BEAMS, BELOW PROVIDE PREFINISHED/PRECOLORED, METAL CAP FLASHING WHERE EXPOSED AT TOP SIDE
313	MEMBRANE ROOF, FULLY ADHERED
314	PREFINISHED, PRECOLORED METAL CAP/FASCIA FLASHING - 228A U.N.O
315	METAL CAP FLASHING WHERE EXPOSED AT TOP SIDE
316	2'-0" STEP (INTERIOR) VAULTED CEILING
317	1'-10" PARAPET
318	1'-0" PARAPET

UPTOWN240

IVANO OTTOBORGO
 240 LAKE DILLON DR.
 DILLON, CO 80435

PH: 970-977-7310
 EMAIL: igad@msn.com

studio
PBA
 1575 GULPH STREET DENVER, CO 80218
 PH: 303.592.2904 FX: 303.592.8387
 www.studiopba.com

UPTOWN240

240 LAKE DILLON DRIVE
 DILLON, COLORADO 80435

- ROOF PLAN GENERAL NOTES**
- ALL ROOF PENETRATIONS SHALL BE INSTALLED VERTICALLY AND PAINTED TO MATCH SURROUNDING SURFACE.
 - ROOF CEILING SYSTEM TO BE 1 HOUR RATED, RE: FLOOR/ROOF TYPE ASSEMBLY SHEET FOR SPECIFIC ASSEMBLY DETAILS.
 - FIRE WALLS TO EXTEND TO UNDERSIDE OF CLASS B (MINIMUM) ROOF SHEATHING WITH NO PENETRATIONS WITHIN 4' OF EITHER SIDE OF WALL. (PER IBC 706.6 EXCEPTION 4)
 - REFER TO PLBG. PLANS FOR INTERIOR DRAIN CONNECTIONS TO STORM DRAIN SYSTEM.
 - ALL SPOT ELEVATIONS ARE TO T.O. PARAPET FRAMING, U.N.O.
 - ROOF AND ROOF TRUSSES SHALL SLOPE TO DRAIN TO TROUGH, OVERFRAME AS NEEDED TO CREATE SLOPE.
 - ROOF PENETRATIONS SHALL BE A MINIMUM OF 2 FEET AWAY FROM DRAIN TROUGH AND MECHANICAL UNITS.
 - ALL ROOF SLOPES 1/4" PER FOOT U.N.O.
 - IF ROOF TOP CONDENSING UNITS ARE USED (IN CASE OF AIR CONDITIONING PROVIDED) PROVIDE BUILT UP STEEL / UNFINISHED RACK SYSTEM ON VIBRATION PEDESTALS.

ROOF PLAN LEGEND:

	INDICATES HORIZONTAL ROOF AREA 4'-0" ON EACH SIDE OF FIRE WALL TO HAVE NO PENETRATIONS
	INDICATES HIGH ROOF
	INDICATES RECESSED TROUGH OVER CORRIDOR BELOW FOR ROOF DRAINS
	INDICATES STEP IN ROOF
	2HR FIREWALL TO CONTINUE TO FACE OF EAVE AND UNDER SIDE OF ROOF SHEATHING
	CONDENSER UNITS, RE: MECHANICAL
	INDICATES DIRECTION OF DOWNWARD SLOPE U.N.O.
	ROOF DRAIN AND OVERFLOW, SEE LABEL ON PLAN

THESE DRAWINGS ARE INCOMPLETE AND ARE INTENDED FOR CONVEYING DESIGN SYSTEM CONCEPTS. ANY PRICING OR BUDGETING PERFORMED WITH THESE DRAWINGS MUST CARRY A CONTINGENCY TO COVER WHAT ITEMS MAY CHANGE OR BE ADDED AS THE DESIGN PROCESS IS COMPLETED.

No.	Description	Date

CURRENT PHASE

SCHEMATIC DESIGN

ISSUE DATE

03/09/2018

KEY PLAN



SHEET TITLE

OVERALL ROOF PLAN

SHEET NUMBER

A117

ARCHITECT'S PROJECT NUMBER Project Number

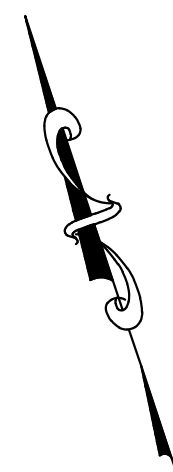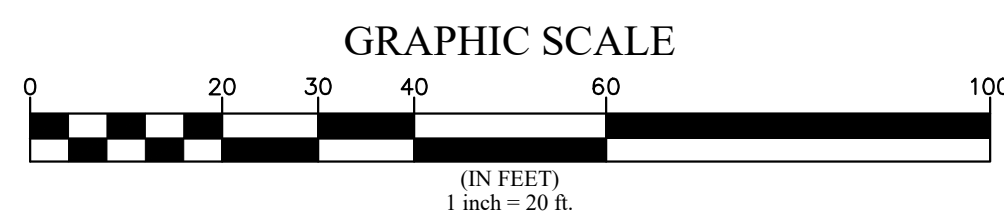

MARCIN ENGINEERING LLC
 130 SKI HILL ROAD, #235
 BRECKENRIDGE, COLORADO
 970-771-3459

GRADING AND DRAINAGE PLAN
 UPTOWN 240
 DILLON, COLORADO

NO.	DATE	REVISIONS	BY
1	02/28/18	TOWN PLANNING	MLB/FRAG

JOB: 17087
 DATE: 02/28/18
 SCALE: 1" = 20'

SHEET
 C-4

Drainage and Detention Summary

Basin: Overall Site
 *ALL ROOF RUNOFF TO BE ROUTED INTERNALLY TO PROPOSED DETENTION VAULT

Existing Conditions (5 yr storm allowable discharge)

A = Basin Area = 1.18 acres
 C_{5yr} = Runoff Coefficient = 0.42
 I_{5yr} = Rainfall Intensity = 2.30 (Tc= 10 min)
 $Q = C * I * A = 1.14$ cfs

Proposed Conditions (100 yr design storm)


Basin Area = 1.18 acres
 C_{100yr} = 0.95

Storage Calculations

$Vol In = C * I * A * Duration$ <-Proposed Conditions
 $Vol Out = (Q) * Duration$ <-Existing Conditions
 $Vol Stored = Vol In - Vol Out$

Duration (min)	I_{100yr}	Vol In (cf)	Vol Out (cf)	Vol Stored (cf)
5	5.92	1991	342	1649
10	4.59	3087	684	2403
15	3.95	3985	1026	2959
20	3.35	4506	1368	3139
25	3.05	5129	1710	3419
30	2.75	5549	2052	3497
60	1.80	7264	4104	3161

NOTE: BOULDERS ARE SHOWN DIAGRAMMATICALLY

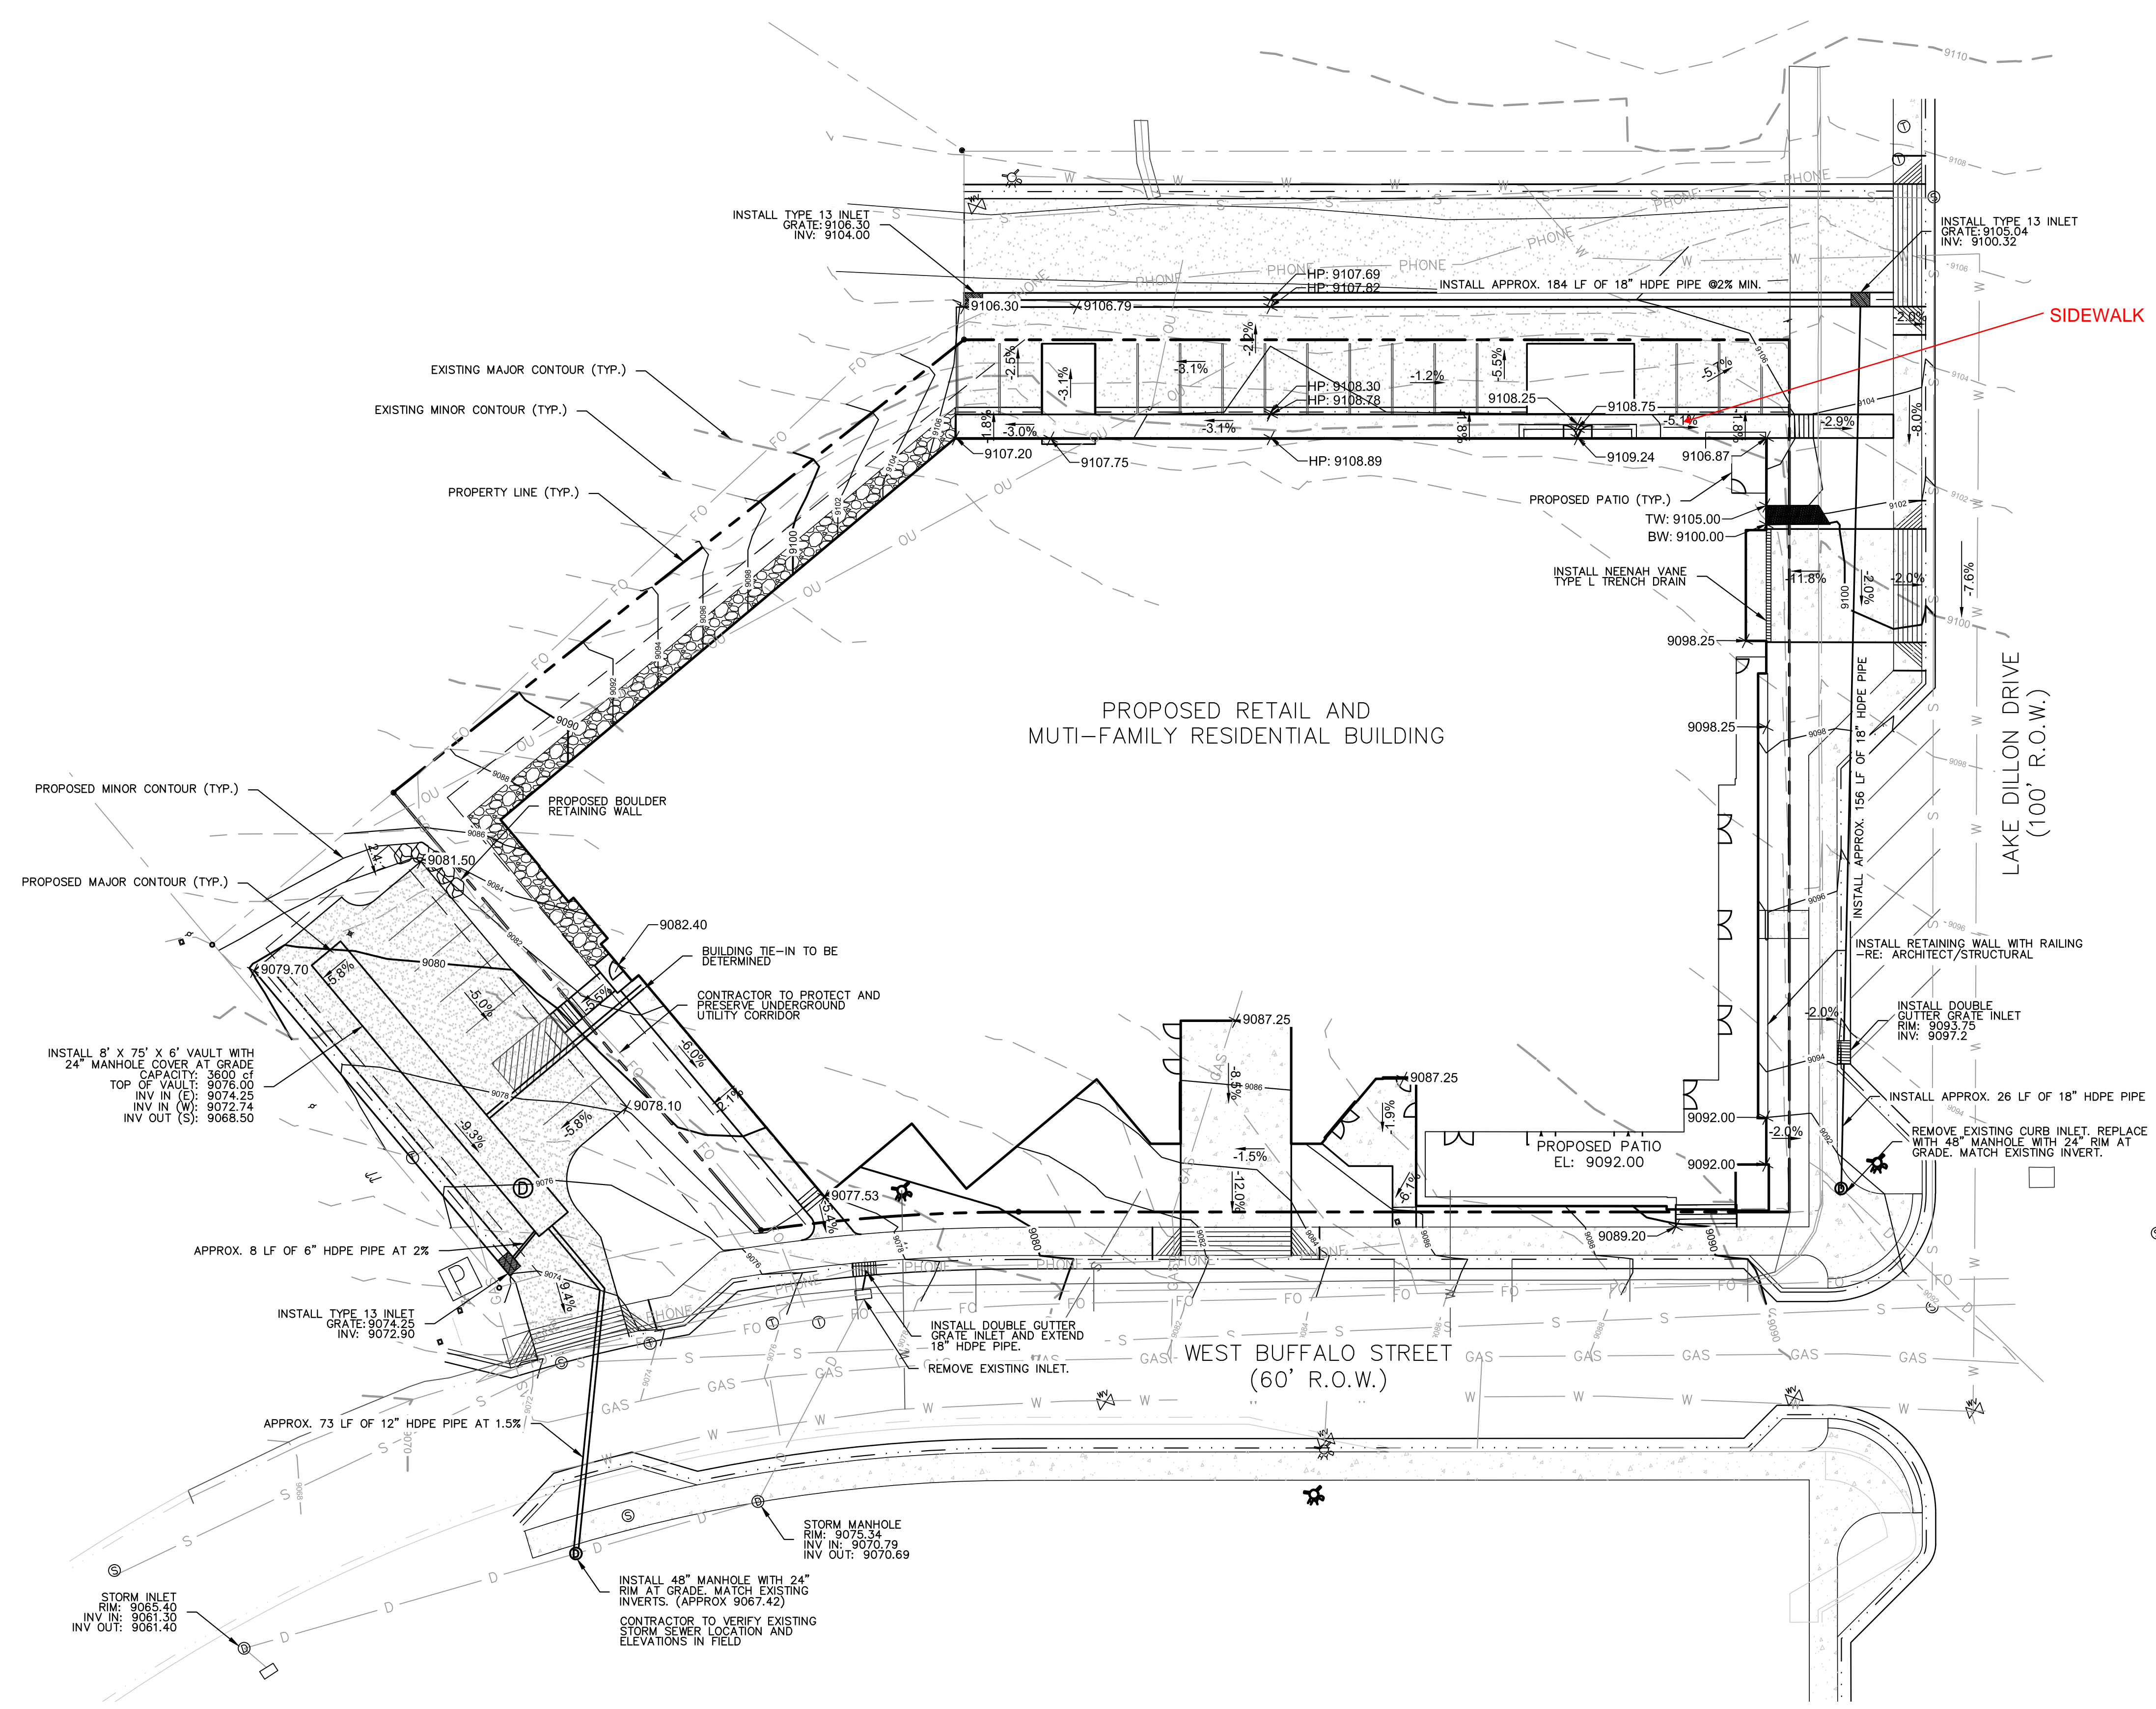

PRELIMINARY - NOT FOR CONSTRUCTION

DRAWING: P:\2017\17087-Uptown 240-25-Grading Plan 2-28-18.dwg