


RESOLUTION PZ 16-18, SERIES OF 2018 APPENDIX A

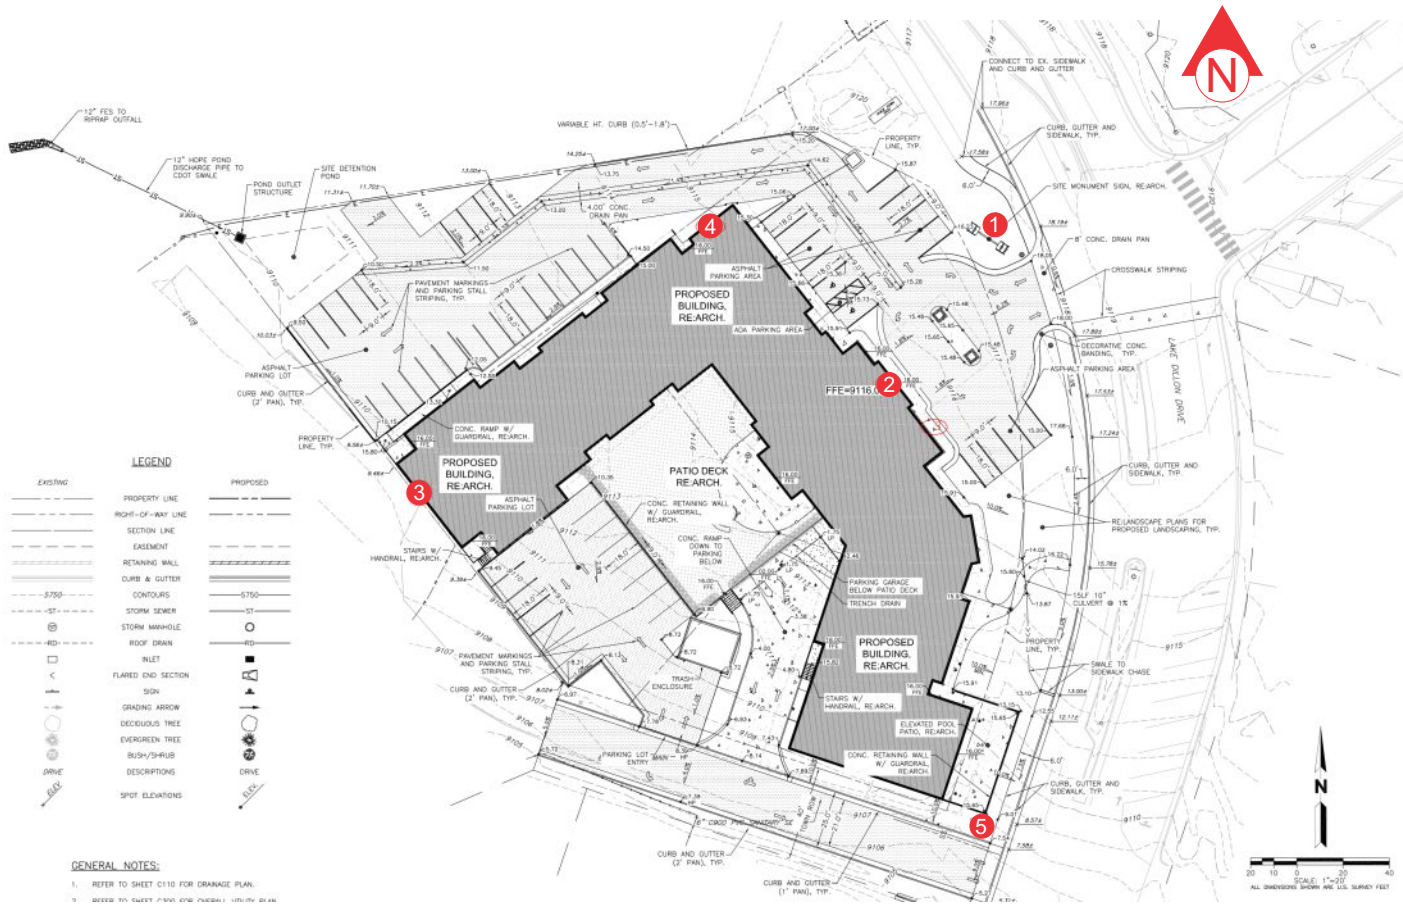

INN CODE: TBD
 HOMEWOOD SUITES
 DILLION, CO

NEW CONSTRUCTION /
 NO EXISTING SIGNS


PROPOSED SIGNS:

- 1 4'-1" X 4'-1" MONUMENT @ 6' OAH
- 2 12" PIN MOUNTED LETTER SET
- 3 24" CHANNEL LETTER SET (STAIR CORE)
- 4 24" CHANNEL LETTER SET
- 5 3'-1" X 3'-1" DIRECTIONAL @ 4' OAH

APPROVAL BOX - PLEASE INITIAL		
CUSTOMER APPROVAL		Date

NOTE: Elevation drawings are for customer approval only, drawings are not to be used as any installation guide, all dimensions must be verified before installation.

Customer: HOMEWOOD SUITES	Date: 8/31/18	Prepared By: AT/CM	Note: Color output may not be exact when viewing or printing this drawing. All colors used are PMS or the closest CMYK equivalent. If these colors are incorrect, please provide the correct PMS match and a revision to this drawing will be made.	<p style="font-size: small; margin-top: 5px;">DISTRIBUTED BY SIGN UP COMPANY 700 21st Street Southwest PO Box 210 Watertown, SD 57201-0210 1.800.843.9888 • www.personasigns.com</p>
Location: DILLION, CO	File Name: 167318 - R3 - DILLION, CO		Eng: -	

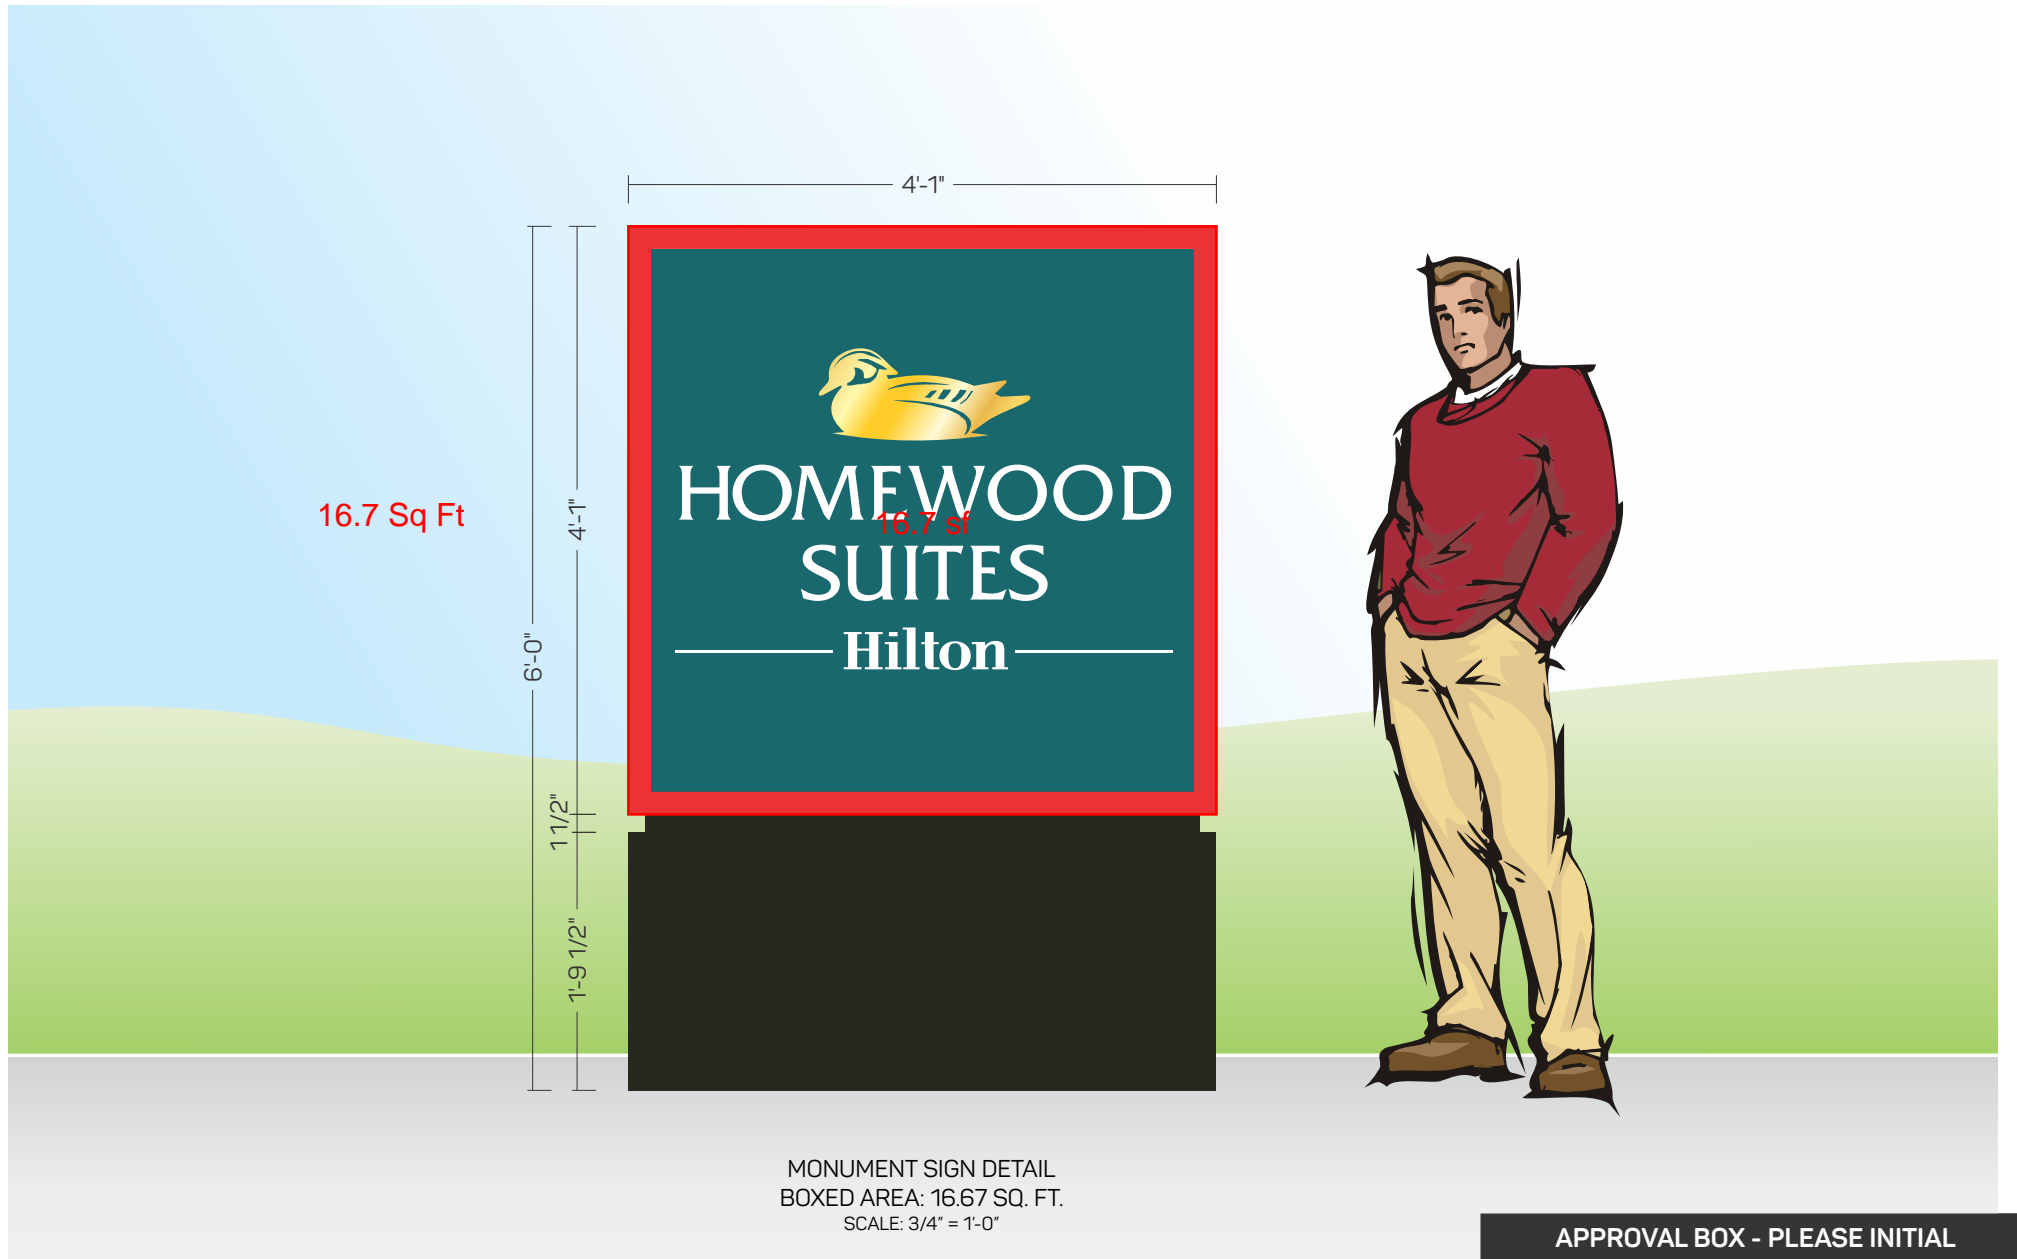

APPROVAL BOX - PLEASE INITIAL		
CUSTOMER APPROVAL		Date

NOTE: Elevation drawings are for customer approval only, drawings are not to be used as any installation guide, all dimensions must be verified before installation.



Customer: HOMEWOOD SUITES	Date: 8/31/18	Prepared By: AT/CM	<small>Note: Color output may not be exact when viewing or printing this drawing. All colors used are PMS or the closest CMYK equivalent. If these colors are incorrect, please provide the correct PMS match and a revision to this drawing will be made.</small>
Location: DILLION, CO	File Name: 167318 - R3 - DILLION, CO	Eng: -	

persóna
 SIGNS | LIGHTING | IMAGE

DISTRIBUTED BY SIGN UP COMPANY
 700 21st Street Southwest
 PO Box 210
 Watertown, SD 57201-0210
 1.800.843.9888 • www.personasigns.com

EAST ELEVATION (MAIN ENTRY)

SCALE: 1/32" = 1'-0"

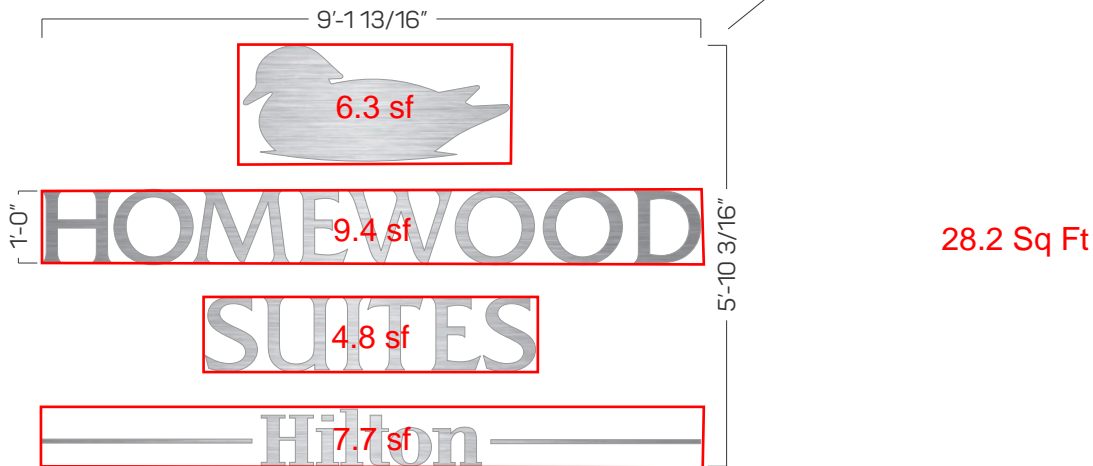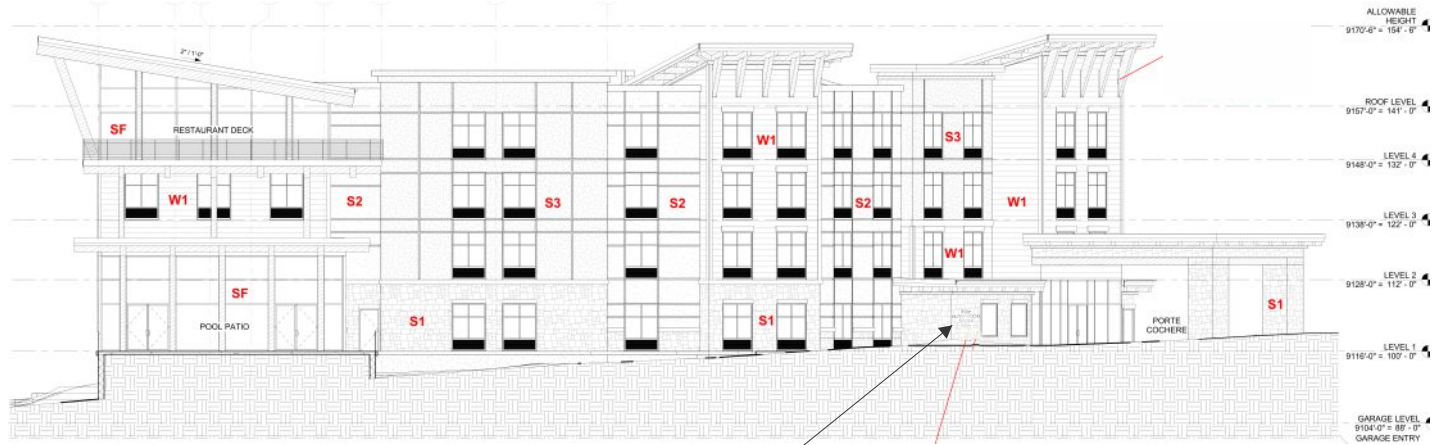

HS-BL X

WALL SIGN DETAIL
 BOXED AREA: 53.51 SQ. FT.
 SCALE: 3/8" = 1'-0"

APPROVAL BOX - PLEASE INITIAL		
CUSTOMER APPROVAL		Date

NOTE: Elevation drawings are for customer approval only, drawings are not to be used as any installation guide, all dimensions must be verified before installation.


Customer: HOMEWOOD SUITES	Date: 5/23/18	Prepared By: AT	<small>Note: Color output may not be exact when viewing or printing this drawing. All colors used are PMS or the closest CMYK equivalent. If these colors are incorrect, please provide the correct PMS match and a revision to this drawing will be made.</small>
Location: DILLION, CO	File Name: 167318 - R3 - DILLION, CO		

persona
 SIGNS | LIGHTING | IMAGE

DISTRIBUTED BY SIGN UP COMPANY
 700 21st Street Southwest
 PO Box 210
 Watertown, SD 57201-0210
 1.800.843.9888 • www.personasigns.com

SOUTH WEST ELEVATION (STAIR CORE SIGN)

SCALE: 1/32" = 1'-0"

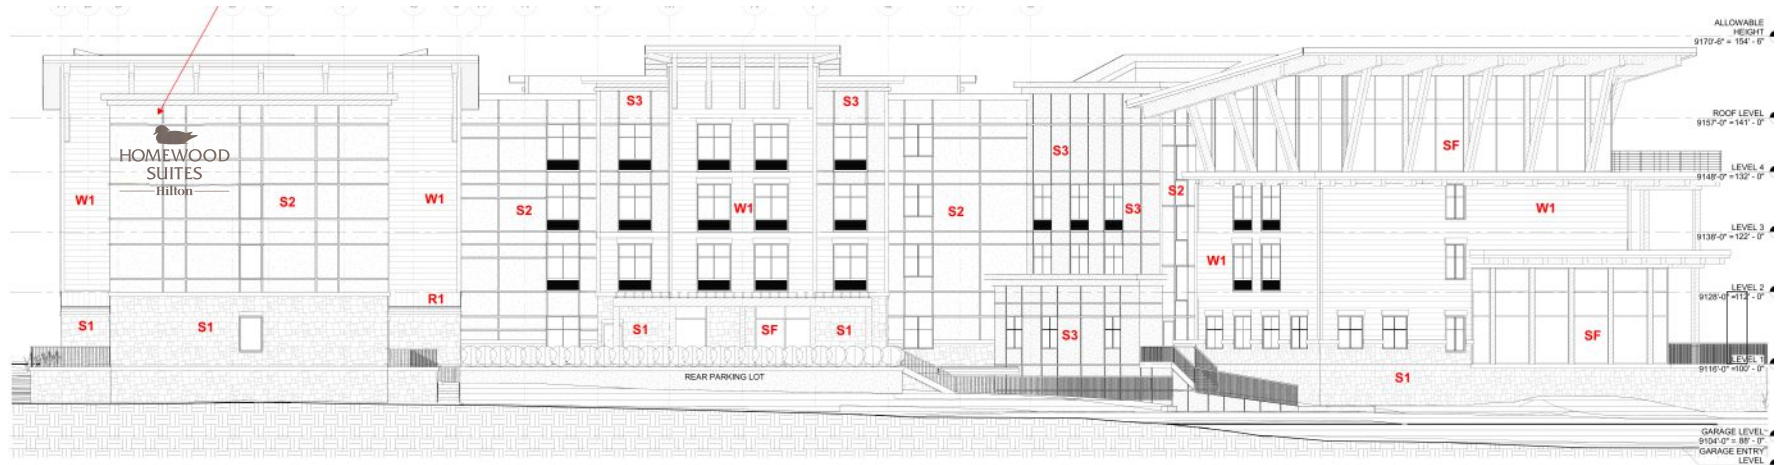

NOTE!
IF THE SIGNS WERE TO BE LIT TOWARDS
THE WALL TO ALLOW A HALO EFFECT

HS-BL X

WALL SIGN DETAIL
BOXED AREA: 214.17 SQ. FT.
SCALE: 3/16" = 1'-0"

APPROVAL BOX - PLEASE INITIAL		
CUSTOMER APPROVAL		Date

NOTE: Elevation drawings are for customer approval only, drawings are not to be used as any installation guide, all dimensions must be verified before installation.



Customer: HOMEWOOD SUITES	Date: 5/23/18	Prepared By: AT	<p>Note: Color output may not be exact when viewing or printing this drawing. All colors used are PMS or the closest CMYK equivalent. If these colors are incorrect, please provide the correct PMS match and a revision to this drawing will be made.</p>
Location: DILLION, CO	File Name: 167318 - R3 - DILLION, CO		

persona
SIGNS | LIGHTING | IMAGE

DISTRIBUTED BY SIGN UP COMPANY
700 21st Street Southwest
PO Box 210
Watertown, SD 57201-0210
1.800.843.9888 • www.personasigns.com

HWY 6 SIDE ELEVATION

SCALE: 1/32" = 1'-0"

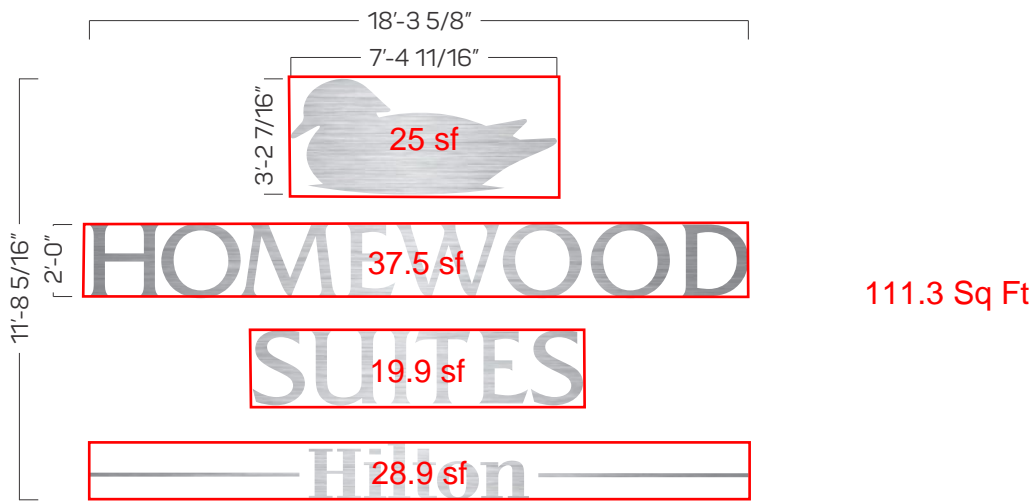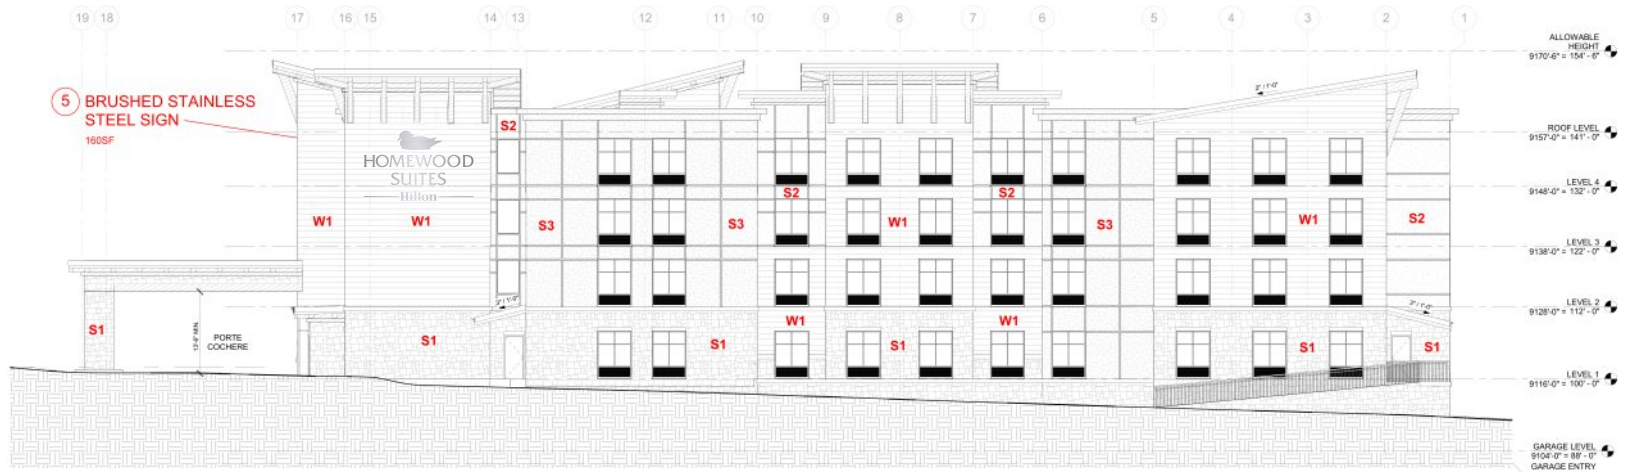


NOTE!
IF THE SIGNS WERE TO BE LIT TOWARDS
THE WALL TO ALLOW A HALO EFFECT

HS-BL X

WALL SIGN DETAIL
BOXED AREA: 148.70 SQ. FT.
SCALE: 3/16" = 1'-0"

APPROVAL BOX - PLEASE INITIAL		
CUSTOMER APPROVAL		Date


NOTE: Elevation drawings are for customer approval only, drawings are not to be used as any installation guide, all dimensions must be verified before installation.

Customer: HOMEWOOD SUITES	Date: 5/23/18	Prepared By: AT	<p>Note: Color output may not be exact when viewing or printing this drawing. All colors used are PMS or the closest CMYK equivalent. If these colors are incorrect, please provide the correct PMS match and a revision to this drawing will be made.</p>	 <p>SIGNS LIGHTING IMAGE</p>	<p>DISTRIBUTED BY SIGN UP COMPANY 700 21st Street Southwest PO Box 210 Watertown, SD 57201-0210 1.800.843.9888 • www.personasigns.com</p>
Location: DILLION, CO	File Name: 167318 - R3 - DILLION, CO	Eng: -			



9.5 Sq Ft

3'-1"

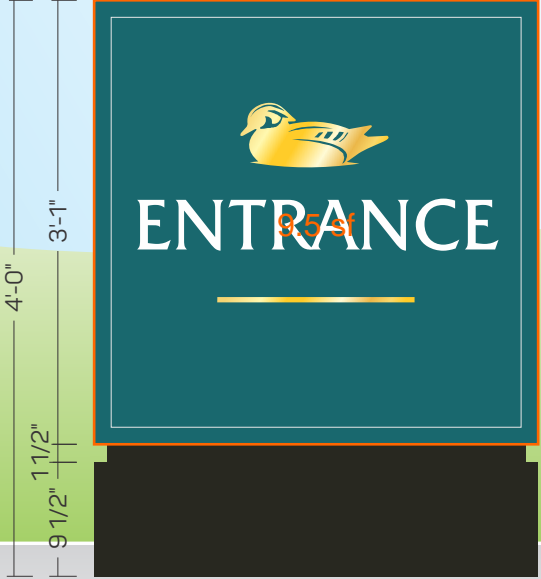

MONUMENT SIGN DETAIL
 BOXED AREA: 9.51 SQ. FT.
 SCALE: 3/4" = 1'-0"



APPROVAL BOX - PLEASE INITIAL		
CUSTOMER APPROVAL		Date

NOTE: Elevation drawings are for customer approval only, drawings are not to be used as any installation guide, all dimensions must be verified before installation.

Customer: HOMEWOOD SUITES	Date: 8/31/18	Prepared By: CM	<small>Note: Color output may not be exact when viewing or printing this drawing. All colors used are PMS or the closest CMYK equivalent. If these colors are incorrect, please provide the correct PMS match and a revision to this drawing will be made.</small>
Location: DILLION, CO	File Name: 167318 - R3 - DILLION, CO	Eng: -	

persóna
 SIGNS | LIGHTING | IMAGE

DISTRIBUTED BY SIGN UP COMPANY
 700 21st Street Southwest
 PO Box 210
 Watertown, SD 57201-0210
 1.800.843.9888 • www.personasigns.com